

Name: Gurich Associates

Service No. 47

Address 15 Nichols Road

6637

Lexington, Mass.

Location 15 Nichols Road

Kind of Pipe

Size

Size of Main

~~REPLACEMENT~~ New Service

Com. 6-15-49

Location

Date	Material	Amount	Total	Date	Amount
May 5, '49	Labor	4 75	4 75	April 5 '49	20 00
	10% Overhead		48	June 20 '49	2 37
	34' - 3/4" Copper Tubing @.27	9 18		July 12 '49	10 06
	1 - 3/4" C x 1/2" I.W.H. S&W	3 29		May 4, '49	3 55
	Littlefield Shovel 2 hrs. @ 7.00	14 00		16' - 3/4" Copper Tubing @.27	4 32
	Trucking 1 hr. @.75	75		1 - 3/4" C Corp-cock	3 15
			32 45	1 - 3/4" C x 3/4" C Curb-cock	3 85
				1 - Box & Rod	3 95
				1 - 1/2" Straight Tail Piece	37
				1 - 1/2" Offset Tail Piece	37
				Littlefield Shovel 1 hr. @ 7.00	7 00
				Trucking 1 hr. @.75	75
	Labor				27 31

Bill sent 6-22-49

Deposited

Cash

Bank

Non-Charge

DATE _____

TOWN OF LEXINGTON - BOARD OF PUBLIC WORKS

WATER DIVISION

The undersigned applies for a supply of water at No..... St. and hereby agrees to comply with the rules and regulations as now, or at any future time, established by the Board of Selectmen.

Am't of Estimate \$.....

Owner


Am't Paid \$.....

Address

Builder

.....

Sketch of Service Here

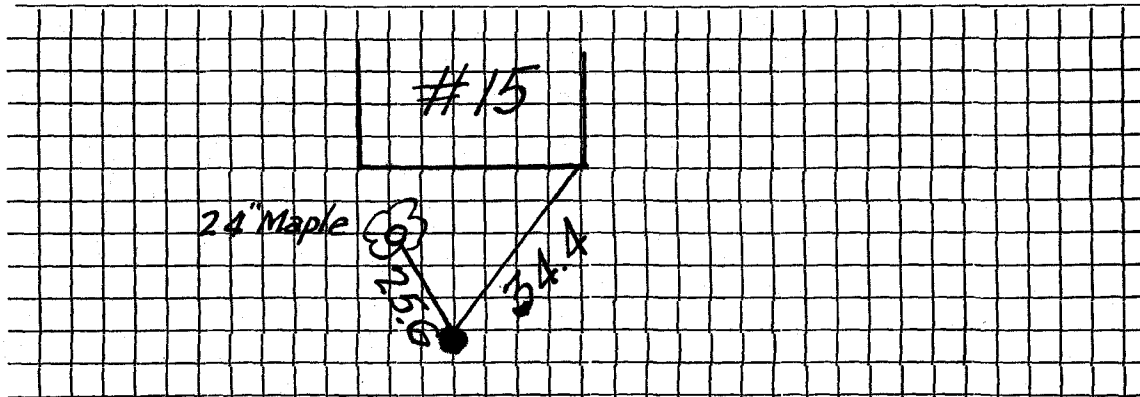

Connection made in Street.

Work completed19

Remarks: