

Name Edmund Naivoishik

Service No. 66 3/68

Address 16 Nichols Road

6459

Lexington, Mass.

Location 16 Nichols Road

666

Kind of Pipe

Size

Size of Main

~~Repair-Renewal~~ New Service

Location

Date	Material	Amount	Total	Date	Location	Amount
July 29, '46	Labor	90	90	July 26, '46	Deposited	25 00
	10% Overhead		09	Nov 29 '46	Refunded	12 22
	43' - $\frac{3}{4}$ " Copper Tubing @ .1911		8 22		Non-Charge	12 78
	1 - $\frac{1}{4}$ " C x $\frac{1}{2}$ " Stop & Waste		2 82	July 27, '46	Labor	26 69
	Trucking 1 hr. @ .75		75	July 29, '46	"	9 45
			12 78	27' - $\frac{3}{4}$ " Copper Tubing @ .1911		5 16
				1 - $\frac{3}{4}$ " C. Corp-cock		2 70
				1 - $\frac{3}{4}$ " C Corp-cock		3 30
				1 - Box & Rod		1 65
				1 - $\frac{1}{2}$ " Straight Tail Piece		90
				1 - $\frac{1}{2}$ " Offset Tail Piece		90
				Trucking 1 hr. @ .75		75
	Labor					51 50

DATE _____

TOWN OF LEXINGTON—BOARD OF PUBLIC WORKS

WATER DIVISION

The undersigned applies for a supply of water at No. _____ St. and hereby agrees to comply with the rules and regulations as now, or at any future time, established by the Board of Selectmen.


Am't. of Estimate \$ _____

Owner _____

Am't. Paid \$ _____

Address _____

Builder _____

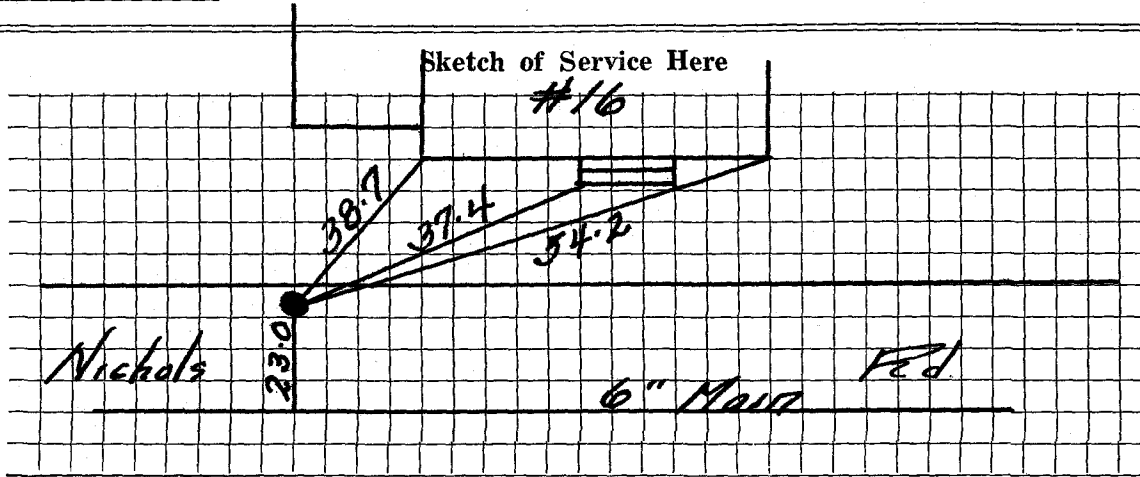

Connection made in _____ Street.

Work completed _____ 19

Remarks: