

## WATER SERVICE RECORD

Name Ralph Frissore

Service No. 321

Address 7 Nichols Road

# 7531

Location


~~Repair~~ ~~Reserve~~ New Service

Card 2-29-60

Date	Material	Amount	Total	Date	Amount	
12-21-59	Labor	1.85		12-4-60	Deposit	50.00
	10% O.H.	.19	2.04	2-29-60	Retard	24.95
	39' 3/4" Copper tubing @.42		16.38			25.05
	1 3/4" C x 1/2 I.W.H. Stop & Waste		5.88		NON CHARGE	
	1 hr. Trucking @.75		.75		1 1/2 Straight tailpiece	.50
			25.05		1 1/2 Offset tailpiece	.50
						1.00

TOWN OF LEXINGTON — BOARD OF PUBLIC WORKS  
WATER DIVISION

Sketch of Service Here

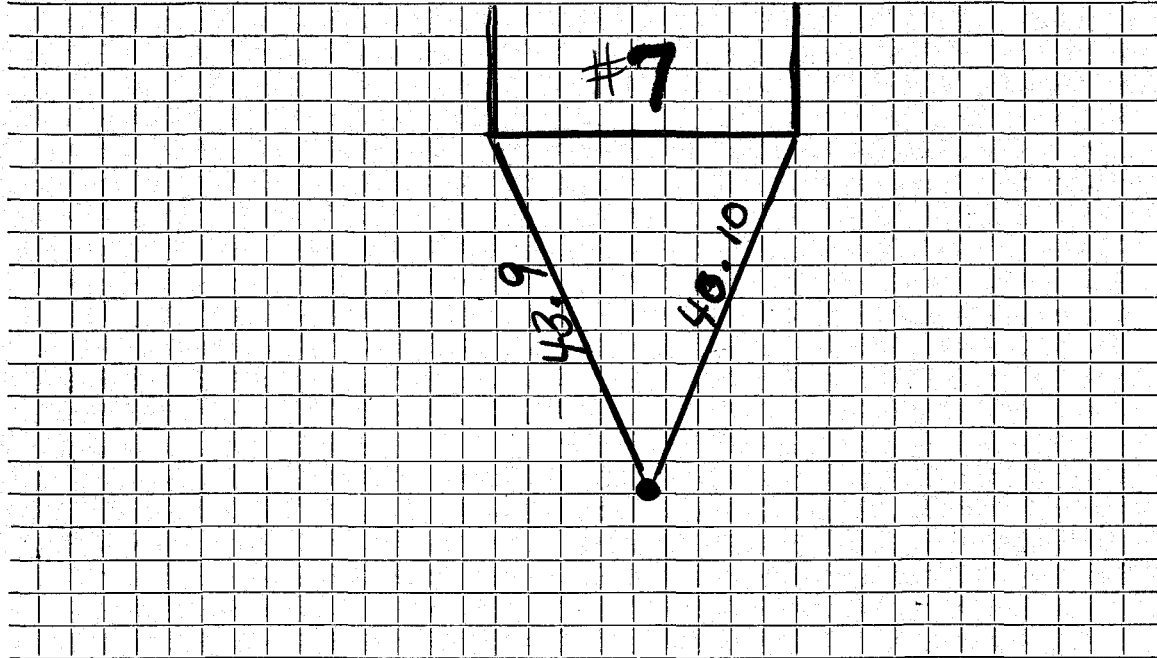

Connection made in ..... Street. Work completed .....

Remarks: .....  
.....  
.....