

WATER SERVICE RECORD

Name Harold White

Service No. 170

Address 8 Nichols Road

Location Lexington, Mass.

~~Repair & Removal~~—New Service


Com. 10/1/51

Date	Material	Amount	Total	Date	Material	Amount
8-8-51	Labor	4 74	4 74	7-20-51	Deposited	75 00
	10% Overhead		41	10-1-51	Refunded	38 67
	35'-3/4" Copper Tubing @.326		11 41			36 33
	1-3/4" Cx 1/2" I.W.H. S&W		1 00		No Charge	
	1-3/4" Cx 3/4" C Union (3 pts)		1 72	8-8-51	Labor	4 74
	2 Hr. Littlefield Shovel		14 00		30'-3/4" Copper Tubing @.326	9 78
	1 Hr. Trucking		75		1-3/4" C Corp-Cock	4 33
			36 33		1-3/4" Cx 3/4" C Curb-Cock	4 67
					1-Box & Rod	4 68
					1-1/2" Offset Tail Piece	50
					1-1/2" Straight Tail Piece	50
					2 Hr. Littlefield Shovel	14 00
					1 Hr. Trucking	75
						43 35

DATE _____

**TOWN OF LEXINGTON — BOARD OF PUBLIC WORKS
WATER DIVISION**

Sketch of Service Here

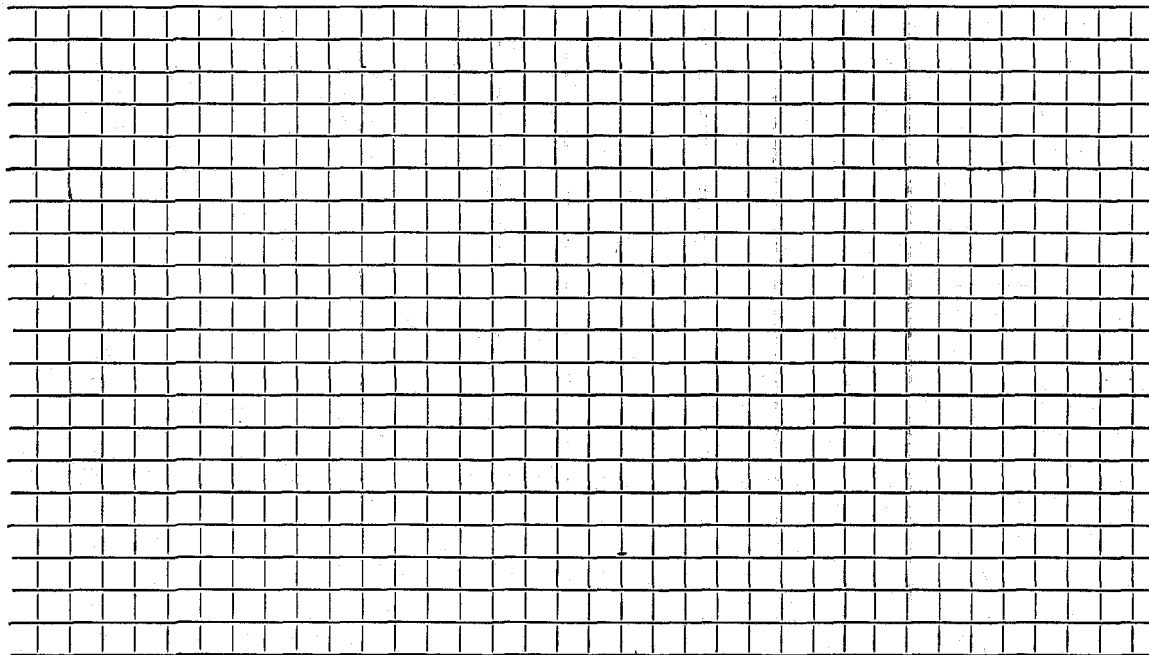

Connection made in Street. Work completed

Remarks:
.....
.....