


DATE 4-13-95

TOWN OF LEXINGTON — BOARD OF PUBLIC WORKS

WATER DIVISION

Sketch of Service Here

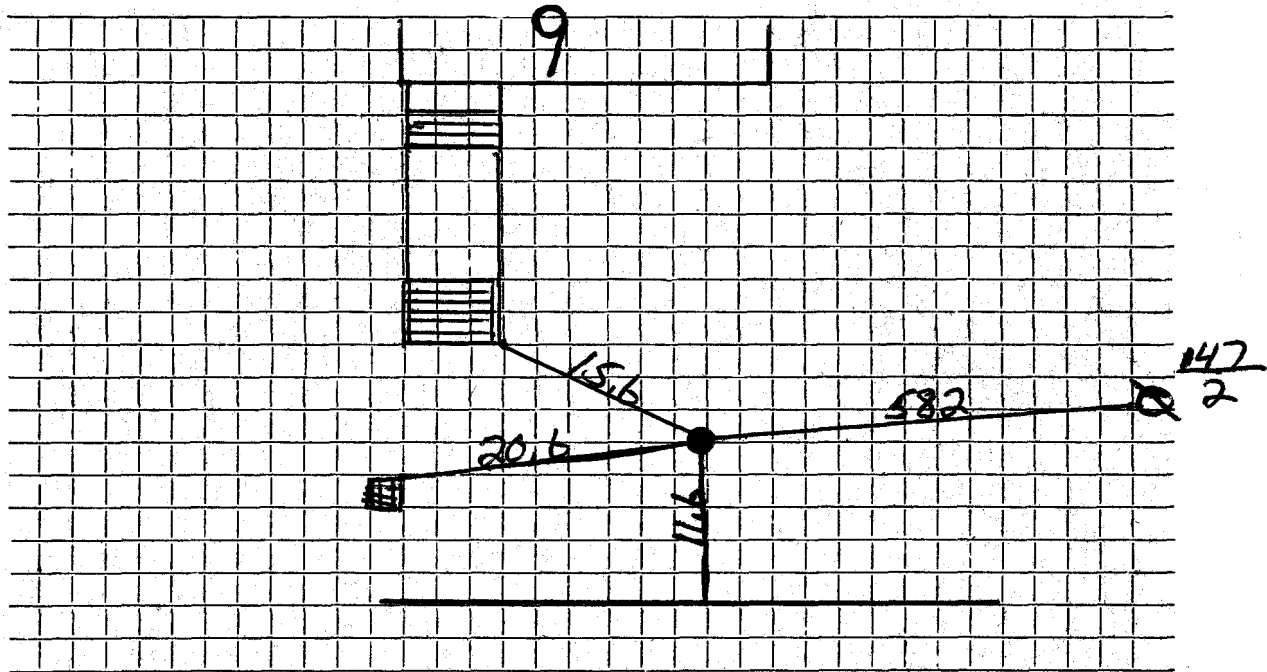

Connection made in Street. Work completed 4-13-95

Remarks: Corp. 4' deep