

Name Custom Built Homes

2359 #2360
Service No. 3309

Address 16 Normandy Road

Lexington, Mass.

Location 16 Normandy Road

Kind of Pipe

Size

Size of Main

~~REPAIR~~ RENEWAL - New Service

Location

Date	Material	Amount	Total	Date	Amount
Jul. 26, '47	Labor	2 10	2 10	July 21 '47	20 00
	10% Overhead		21	Sept 25 '47	2 67
	35' - 3/4" Copper Tubing @.28		9 80		17 33
	1 - 3/4" C x 1/2" I.W.H. S & W		3 15	Jul. 26, '47	15 00
	1 - 3/4" C x 3/4" C Union (3 pts)		1 32	25' - 3/4" Copper Tubing @.28	7 00
	Trucking 1 hr. @.75		75	1 - 3/4" C Corp-cock	3 00
			17 33	1 - 3/4" C x 3/4" C Curb-cock	3 68
				1 - Box & Rod	4 26
				1 - 1/2" Straight Tail Piece	30
				1 - 1/2" Offset Tail Piece	30
				Trucking 1 hr. @.75	75
					34 29
	Labor				

Hadley Press, Inc., Lexington

DATE _____

TOWN OF LEXINGTON—BOARD OF PUBLIC WORKS

WATER DIVISION

The undersigned applies for a supply of water at No. _____ St. and hereby agrees to comply with the rules and regulations as now, or at any future time, established by the Board of Selectmen.

Am't. of Estimate \$ _____


Owner _____

Am't. Paid \$ _____

Address _____

Builder _____

Sketch of Service Here

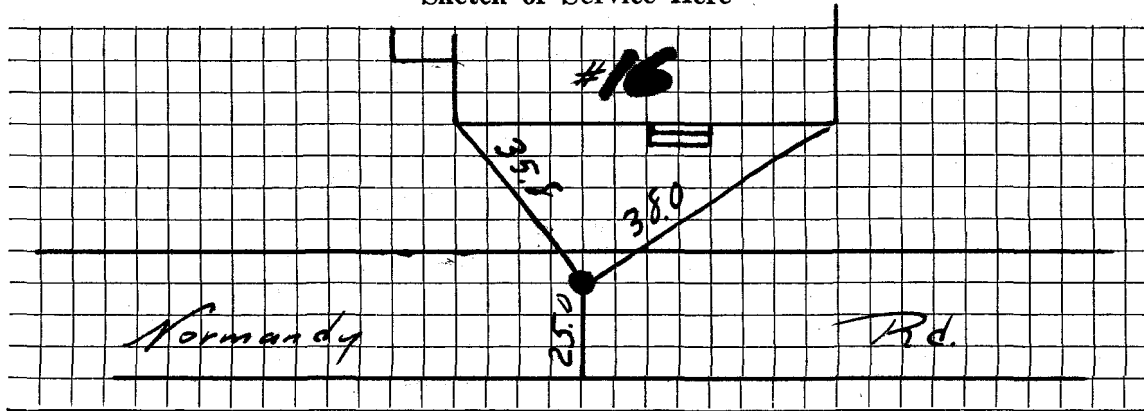

Connection made in _____ Street.

Work completed _____ 19

Remarks: