

Name Custom Built Homes

Service No. ⁷² 3321

Address 22 Normandy Road

5163

Lexington, Mass.

Location 22 Normandy Road

Kind of Pipe

Size

Size of Main

~~Repair - Renewal~~ - New Service

Location

| Date | Material | Amount | Total | Date | Amount |
|--------------|-----------------------------------|--------|-------|-------------------------------|--------|
| Jul. 26, '47 | Labor | 15 48 | 15 48 | July 25 '47 | 45 00 |
| | 10% Overhead | | 1 55 | Sept 25 '47 | 12 67 |
| | 36' - 3/4" Copper Tubing @.28 | | 10 08 | | 32 33 |
| | 1 - 3/4" C x 1/2" I.W.H. S & W | | 3 15 | Non-Charge | |
| | 1 - 3/4" C x 3/4" C Union (3 pts) | | 1 32 | Jul. 26, '47 Labor | 11 18 |
| | Trucking 1 hr. @.75 | | 75 | 26' - 3/4" Copper Tubing @.28 | 7 28 |
| | | | 32 33 | 1 - 3/4" C Corp-cock | 3 00 |
| | | | | 1 - 3/4" C x 3/4" C Curb-cock | 3 68 |
| | | | | 1 - Box & Rod | 4 26 |
| | | | | 1 - 1/8" Offset Tail Piece | 30 |
| | | | | 1 - 1/2" Straight Tail Piece | 30 |
| | | | | Trucking 1 hr. @.75 | 75 |
| | | | | | 30 75 |
| | Labor | | | | |

Hadley Press, Inc., Lexington

TOWN OF LEXINGTON—BOARD OF PUBLIC WORKS

WATER DIVISION

The undersigned applies for a supply of water at No. _____ St. and hereby agrees to comply with the rules and regulations as now, or at any future time, established by the Board of Selectmen.

Am't. of Estimate \$ _____


Owner _____

Am't. Paid \$ _____

Address _____

Builder _____

Sketch of Service Here

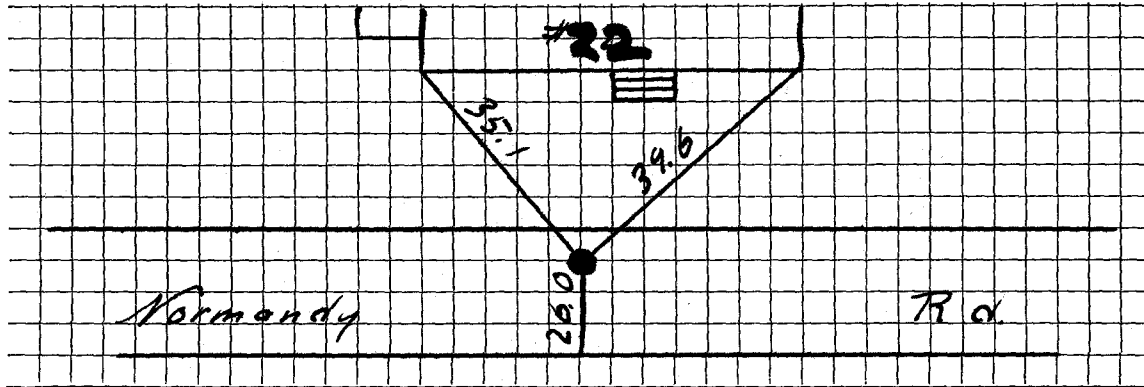

Connection made in _____ Street.

Work completed _____ 19

Remarks: