

Name Custom Built Homes

Service No. ⁷² 3317

Address 23 Normandy Road

3032

Lexington, Mass.

Location 23 Normandy Road

Kind of Pipe

Size

Size of Main

~~Repair - Renewal~~ - New Service

Location

Date

Material

Amount

Total

Date

Amount

Jul. 26, '47

Labor

17 20

17 20

July 25 '47

Deposited

45 00

10% Overhead

1 72

Sept 25 '47

Refunded

9 60

40' - 3/4" Copper Tubing @.28

11 20

Non-Charge

35 34

1 - 3/4" C x 1/2" I.W.H. S & W

3 15

Jul. 26, '47 Labor

5 16

1 - 3/4" C x 3/4" C Union (3 pts)

1 32

12' - 3/4" Copper Tubing @.28

3 36

Trucking 1 hr. @.75

75

1 - 3/4" C Corp-cock

3 00

35 34

1 - 3/4" C x 3/4" C Curb-cock

3 68

1 - Box & Rd

4 26

1 - 1/2" Straight Tail Piece

30

1 - 1/2" Offset Tail Piece

30

Trucking 1 hr. @.75

75

20 81

Labor

DATE _____

TOWN OF LEXINGTON—BOARD OF PUBLIC WORKS

WATER DIVISION

The undersigned applies for a supply of water at No. _____ St. and hereby agrees to comply with the rules and regulations as now, or at any future time, established by the Board of Selectmen.

Am't. of Estimate \$ _____


Owner _____

Am't. Paid \$ _____

Address _____

Builder _____

Sketch of Service Here

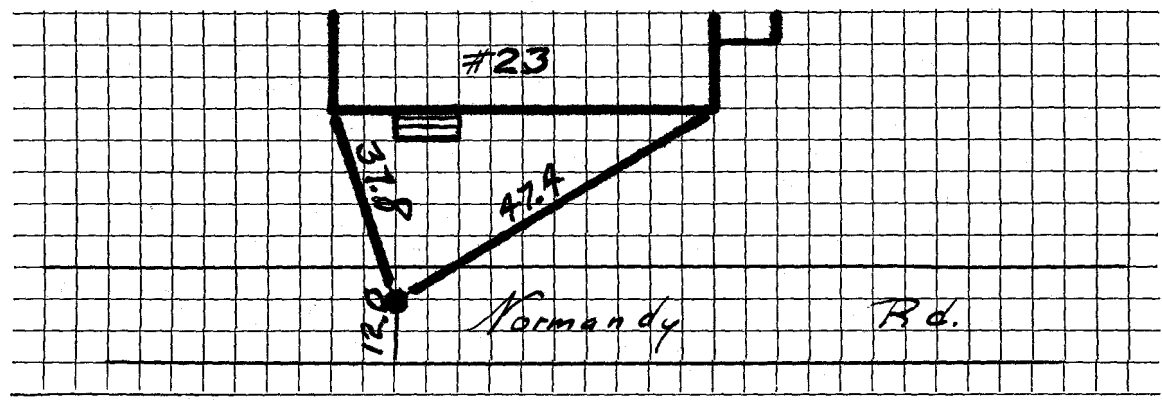

Connection made in _____ Street.

Work completed _____ 19

Remarks: