


DATE _____

TOWN OF LEXINGTON — BOARD OF PUBLIC WORKS
WATER DIVISION

Sketch of Service Here

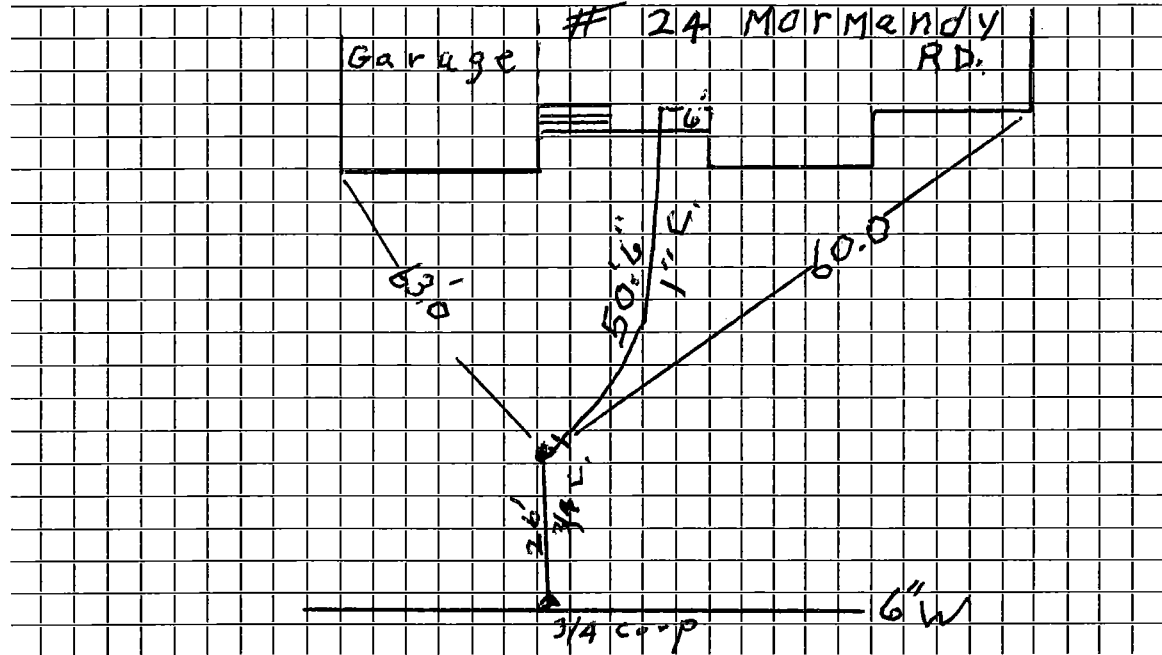

Connection made in..... Street.

Work completed 11/10/11 J. McLaw

Remarks:.....
.....
.....