

Name Custom Built Homes

Service No.

72

3320

Address 25 Normandy Road

Lexington, Mass.

Location 25 Normandy Road

Kind of Pipe

Size

Size of Main

~~Repair~~ ~~Renewal~~ New Service

Location

Date	Material	Amount	Total	Date	Amount
Jul. 26, '47	Labor	17 20	17 20	July 25 '47	45 00
	10% Overhead		1 72	Sept 25 '47	9 00
	40' - 3/4" Copper Tubing @.28		11 20		35 34
	1 - 3/4" C x 1" I.W.H. S & W		3 15	Jul. 26, '47	5 16
	1 - 3/4" C x 3/4" C Union (3 pts)		1 32	12' - 3/4" Copper Tubing @.28	3 36
	Trucking 1 hr. @.75		75	1 - 3/4" C Corp-cock	3 00
			35 34	1 - 3/4" C x 3/4" C Curb-cock	3 68
				1 - Box & Rod	4 26
				1 - 1/2" Straight Tail Piece	30
				1 - 1/2" Offset Tail Piece	30
				Trucking 1 hr. @.75	75
	Labor				20 81

Hadley Press, Inc., Lexington

Deposited
Refunded
Non-Charge

DATE _____

TOWN OF LEXINGTON—BOARD OF PUBLIC WORKS

WATER DIVISION

The undersigned applies for a supply of water at No. _____ St. and hereby agrees to comply with the rules and regulations as now, or at any future time, established by the Board of Selectmen.

Am't. of Estimate \$ _____


Owner _____

Am't. Paid \$ _____

Address _____

Builder _____

Sketch of Service Here

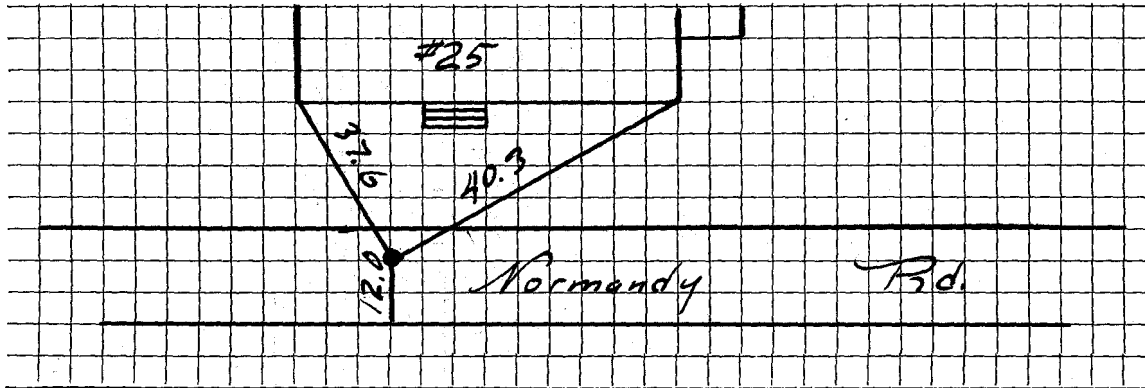

Connection made in _____ Street.

Work completed _____ 19

Remarks: