

Name Custom Built Homes

Service No. 3306

Address 26 Normandy Road

4629

Lexington, Mass.

Location 26 Normandy Road

Kind of Pipe

Size

Size of Main

~~Repair - Renewal~~ New Service

Location

Date	Material	Amount	Total	Date	Amount
Jul. 26, '47	Labor	24 56	24 56	July 21, '47	20 00
	10% Overhead		2 46	Sept 25 '47	26 47
	39' - 3/4" Copper Tubing @.28	10 92			46 49
	1 - 3/4" C x 1/2" I.W.H. S & W	3 15		Jul. 26, '47	70 89
	1 - 3/4" C x 3/4" C Union (3 pts)	1 32		26' - 3/4" Copper Tubing @.28	7 28
	Dynamite 4 lbs. @.21	84		1 - 3/4" C Corp-cock	3 00
	Exploders 7 @ .105	74		1 - 3/4" C x 3/4" C Curb-cock	3 68
	Compressor 1 hr. @1.75	1 75		1 - Box & Rod	4 26
	Trucking 1 hr. @.75	75		Dynamite 16 lbs. @.21	3 36
		46 49		Exploders 25 @.105	2 63
				1 Offset & 1 Straight Tail Piece	60
				Compressor 4 hrs. @1.75	7 00
	Labor			Trucking 1 hr. @.75	75
					103 45

*Deposited
and*

Non-Charge

Hadley Press, Inc., Lexington

DATE _____

TOWN OF LEXINGTON—BOARD OF PUBLIC WORKS

WATER DIVISION

The undersigned applies for a supply of water at No. _____ St. and hereby agrees to comply with the rules and regulations as now, or at any future time, established by the Board of Selectmen.

Am't. of Estimate \$ _____


Owner _____

Am't. Paid \$ _____

Address _____

Builder _____

Sketch of Service Here

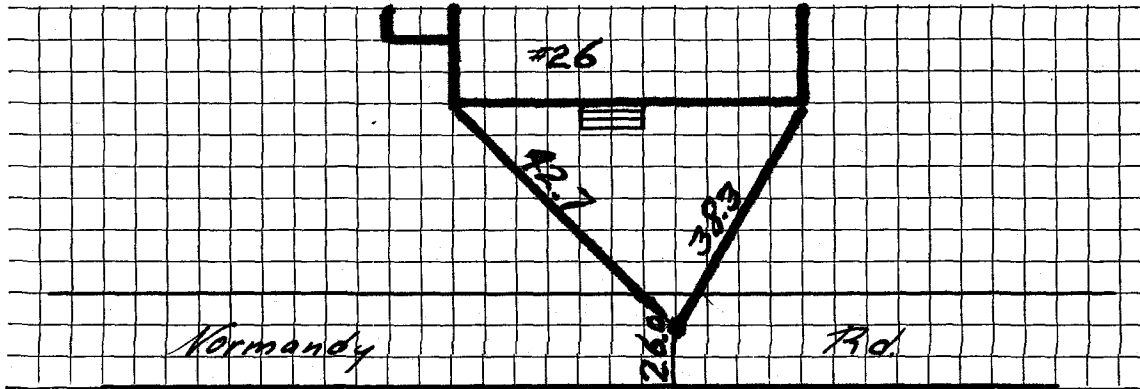

Connection made in _____ Street.

Work completed _____ 19

Remarks: