

Name Custom Built Homes

Service No. ⁶⁹ 3307

Address 28 Normandy Road

6939

Lexington, Mass.

Location 28 Normandy Road

7612

Kind of Pipe

Size

Size of Main

~~Repair/Renewal~~ - New Service

Location

Date	Material	Amount	Total	Date	Location	Amount
Jul. 26, '47	Labor	2 10	2 10	July 21 '47	Deposited	20 00
	10% Overhead		21	Sept 15 '47	Refunded	1 83
	38' - 3/4" Copper Tubing @.28	10 64			Non-Charge	18 17
	1 - 3/4" C x 1/2" I.W.H. S & W	3 15		Jul. 26, '47	Labor	16 20
	1 - 3/4" C x 3/4" C Union (3 pts)	1 32		27' - 3/4" Copper Tubing @.28		7 56
	Trucking 1 hr. @.75		75	1 - 3/4" C Corp-cock		3 00
			18 17	1 - 3/4" C x 3/4" C Curb-cock		3 68
				1 - Box & Rod		4 26
				1 - 1/2" Straight Tail Piece		30
				1 - 1/2" Offset Tail Piece		30
				Trucking 1 hr. @.75		75
						36 05
	Labor					

Hadley Press, Inc., Lexington

DATE _____

TOWN OF LEXINGTON—BOARD OF PUBLIC WORKS

WATER DIVISION

The undersigned applies for a supply of water at No. _____ St. and hereby agrees to comply with the rules and regulations as now, or at any future time, established by the Board of Selectmen.

Am't. of Estimate \$ _____


Owner _____

Am't. Paid \$ _____

Address _____

Builder _____

Sketch of Service Here

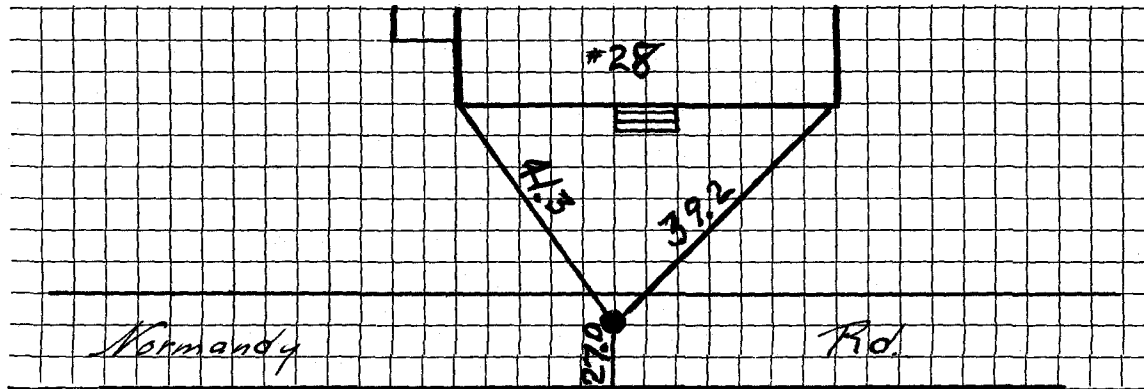

Connection made in _____ Street.

Work completed _____ 19

Remarks: