

Name Custom Built Homes

Service No.

7592²⁶⁶

Address 36 Normandy Road

Lexington, Mass.

Location 36 Normandy Road

Kind of Pipe

Size

Size of Main

~~REPAIR & RENEW~~ - New Service

Location

Date	Material	Amount	Total	Date	Amount
Nov. 19, '48	Labor	3 15	3 15	Nov. 2, '48 Deposited	40 00
Dec. 15, '48	"	3 00	3 00	Dec. 31 '48 Refunded	3 11
	10% Overhead		62	Non charge	36 89
	65'-3/4" Copper Tubing @ .255	16 58		Nov. 19, '48 Labor	3 15
	1-3/4" C x 1/2" I.W.H.S&W	3 15		28'-3/4" Copper Tubing @ .255	7 14
	2-3/4" C x 3/4" C. Union(3 pts)	2 64		1-3/4" C. Corp-cock	3 00
	1 hr. Littlefield Shovel	7 00		1-3/4" C x 3/4" C. Curb-cock	3 68
	1 hr. Trucking	75		1-Box & Rod	3 55
			36 89	1-1/2" Offset Tail Piece	30
				1-1/2" Straight Tail Piece	30
				1 hr. Littlefield Shovel	7 90
				1 hr. Trucking	75
	Labor				28 87

DATE _____

TOWN OF LEXINGTON - BOARD OF PUBLIC WORKS

WATER DIVISION

The undersigned applies for a supply of water at No..... St. and hereby agrees to comply with the rules and regulations as now, or at any future time, established by the Board of Selectmen.

Am't of Estimate \$.....

Owner


Am't Paid \$.....

Address

Builder

.....

Sketch of Service Here

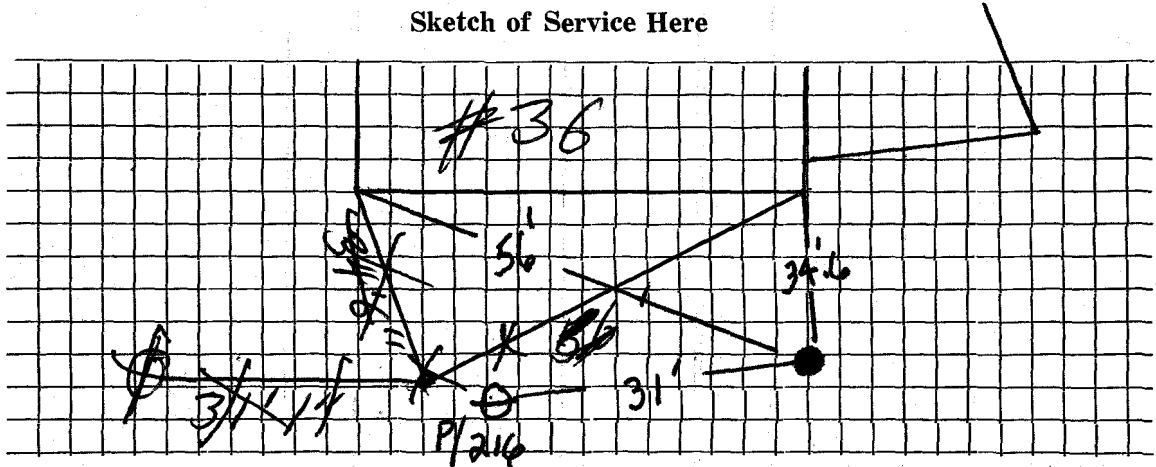

Connection made in Street.

Work completed19

Remarks: