

Name Custom Built Homes

Service No.

266 #5865

Address 38 Normandy Road

Lexington, Mass.

Location

38 Normandy Road

Kind of Pipe

Size

Size of Main

~~Repair & Renewal~~ - New Service

Location

Date	Material	Amount	Total	Date	Amount
Nov. 19, '48	Labor	3 15	3 15	Nov. 2, '48	Deposited
Dec. 15, '48	"	3 00	3 00	Dec. 31, '48	Deposited
	10% Overhead		62		Non charge
	58'-3/4" Copper Tubing @ .255	14 79		Nov. 19, '48	Labor
	1-3/4" C x 1/2" I.W.H. S&W	3 15			28'-3/4" Copper Tubing @ .255
	1-3/4" C x 3/4" C. Union (3 pts)	1 32			1-3/4" C. Corp-cock
	1 hr. Littlefield Shovel	7 00			1-3/4" C x 3/4" C. Curb-cock
	1 hr. Trucking		75		1-Box & Rod
			33 78		1-1/2" Offset Tail Piece
					1-1/2" Straight Tail Piece
					1 hr. Littlefield Shovel
					1 hr. Trucking
	Labor				
					28 87

DATE _____

TOWN OF LEXINGTON - BOARD OF PUBLIC WORKS

WATER DIVISION

The undersigned applies for a supply of water at No..... St. and hereby agrees to comply with the rules and regulations as now, or at any future time, established by the Board of Selectmen.

Am't of Estimate \$.....

Owner


Am't Paid \$.....

Address

Builder

.....

Sketch of Service Here

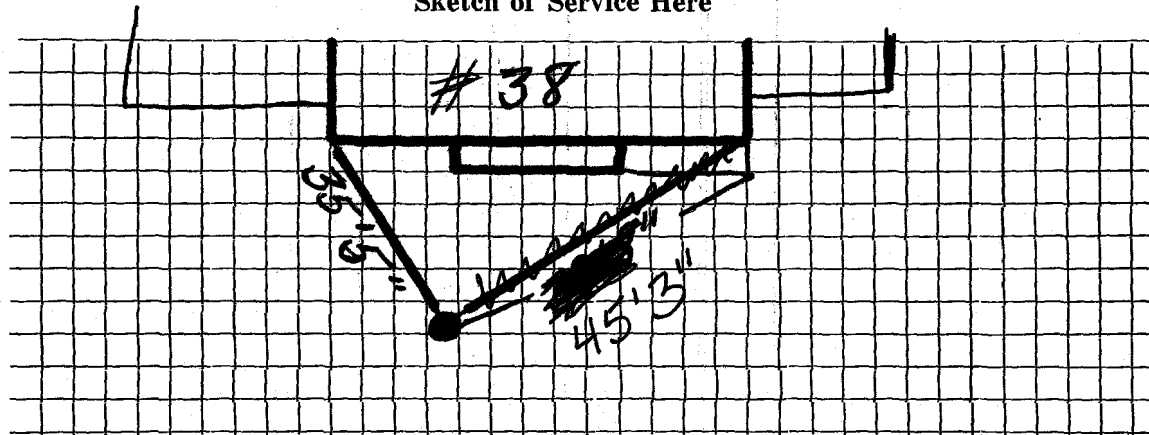

Connection made in Street.

Work completed19

Remarks: