

Name Custom Built Homes

Service No. 266

Address 39 Normandy Road

Lexington, Mass.

Location

39 Normandy Road

Kind of Pipe

Size

Size of Main

~~Repair~~ ~~Reconnect~~ New Service

Location

Date	Material	Amount	Total	Date	Amount
Nov. 19, '48	Labor	3 15	3 15	Nov. 2, '48	40 00
Dec. 15, '48	"	3 00	3 00	Dec. 31, '48	2 90
	10% Overhead		62		Non charge
	71'-3/4" Copper Tubing @ .255	18 11		Nov. 19, '48	Labor
	1-3/4" C x 1/2" I.W.H. S&W	3 16			12'-3/4" Copper Tubing @ .255
	1-3/4" C x 3/4" C. Union (3 pts)	1 32			1-3/4" C. Corp-cock
	1 hr. Littlefield Shovel	7 00			1-3/4" C x 3/4" C. Curb-cock
	1 hr. Trucking		75		1-Box & Rod
			37 10		1-1/2" Offset Tail Piece
					1-1/2" Straight Tail Piece
					1 hr. Littlefield Shovel
					1 hr. Trucking
	Labor				24 79

DATE _____

TOWN OF LEXINGTON - BOARD OF PUBLIC WORKS

WATER DIVISION

The undersigned applies for a supply of water at No..... St. and hereby agrees to comply with the rules and regulations as now, or at any future time, established by the Board of Selectmen.

Am't of Estimate \$.....

Owner


Am't Paid \$.....

Address

Builder

.....

Sketch of Service Here

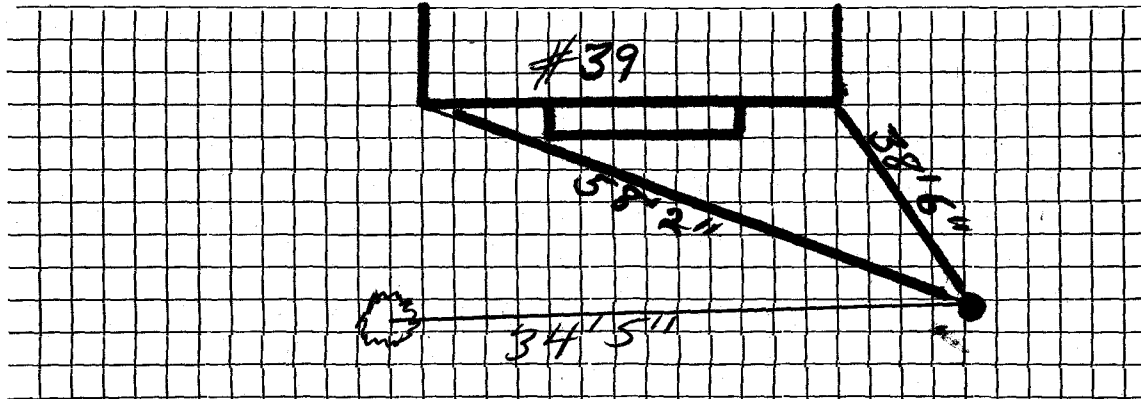

Connection made in Street.

Work completed19

Remarks: