


Date: 05/21/24

TOWN OF LEXINGTON - BOARD OF PUBLIC WORKS  
WATER DIVISION

SKETCH OF SERVICE HERE  
41 NORMANDY RD

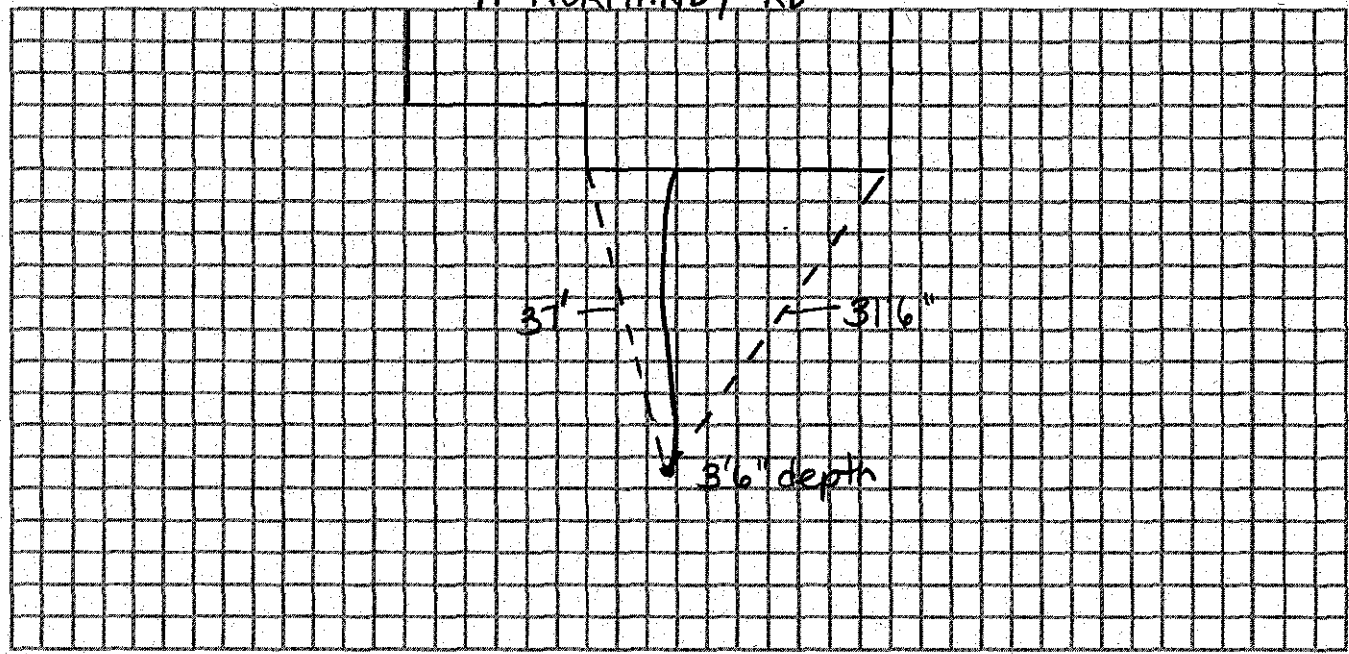

Connection made in: \_\_\_\_\_ Street: \_\_\_\_\_ Work completed: \_\_\_\_\_  
Remarks: Installed by J.M. McLaughlin Inc.

