




DATE July 2001

TOWN OF LEXINGTON — BOARD OF PUBLIC WORKS

WATER DIVISION

Sketch of Service Here

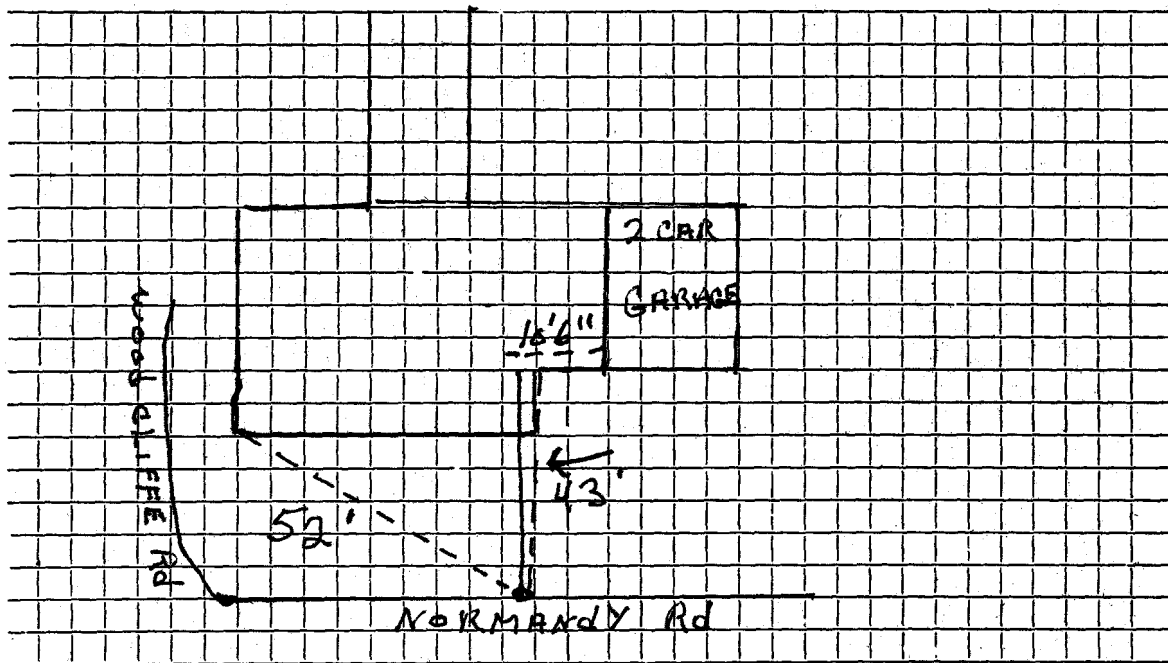

Connection made in NORMANDY..... Rd... Street. Work completed .....

Remarks: INSTALLED... by... J.M. McLAUGHLIN.....