




DATE 9-12-'90

TOWN OF LEXINGTON — BOARD OF PUBLIC WORKS

**WATER DIVISION**

Sketch of Service Here

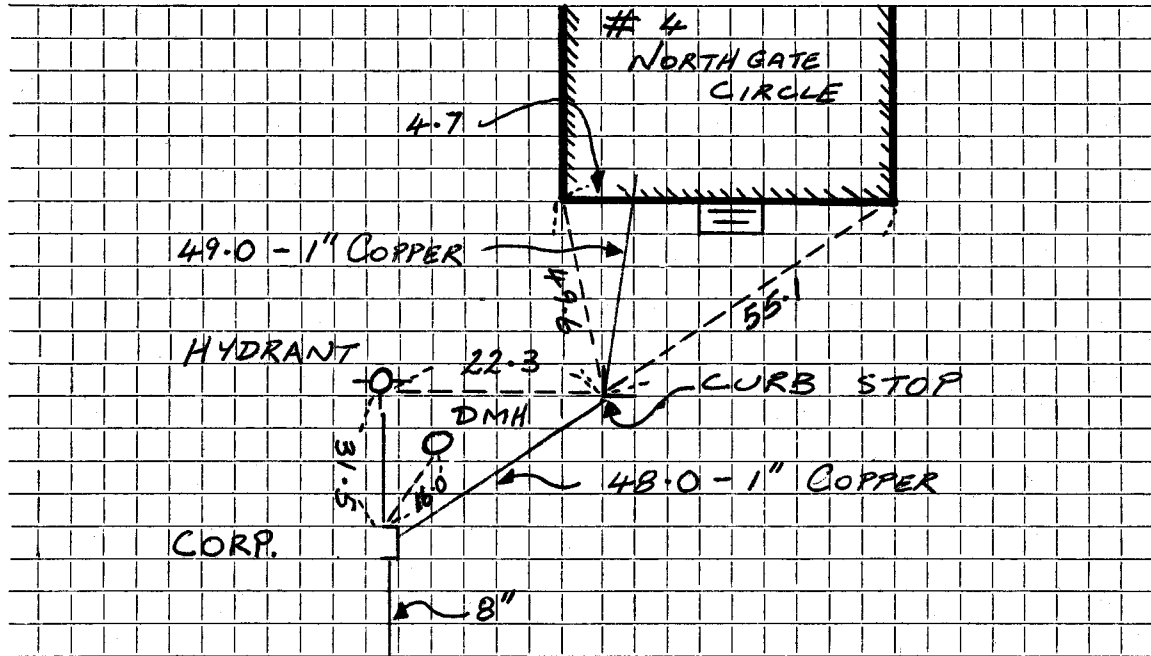

Connection made in ... NORTHGATE CIRCLE ~~Street~~.

Work completed .....

Remarks: .....

.....

.....