




DATE 8/30/19

TOWN OF LEXINGTON — BOARD OF PUBLIC WORKS

WATER DIVISION

Sketch of Service Here

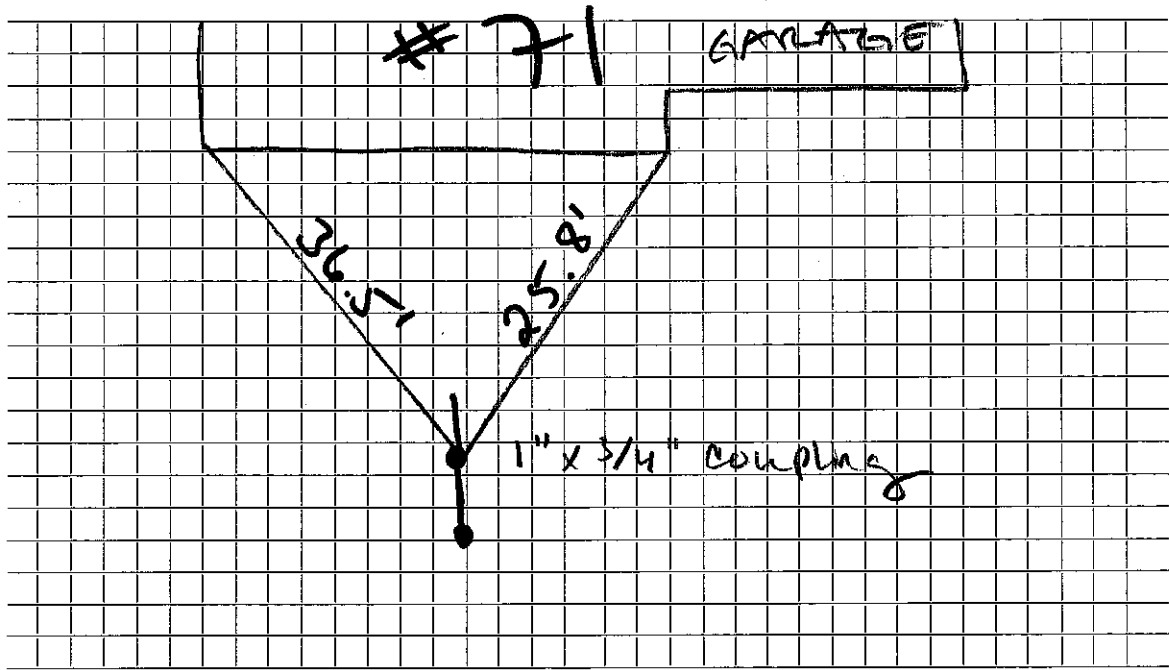

Connection made in... North Hancock Street.

Work completed .....

Remarks:.....  
.....  
.....