


DATE 7/11/90
G.T.S.

TOWN OF LEXINGTON — BOARD OF PUBLIC WORKS

WATER DIVISION

Sketch of Service Here

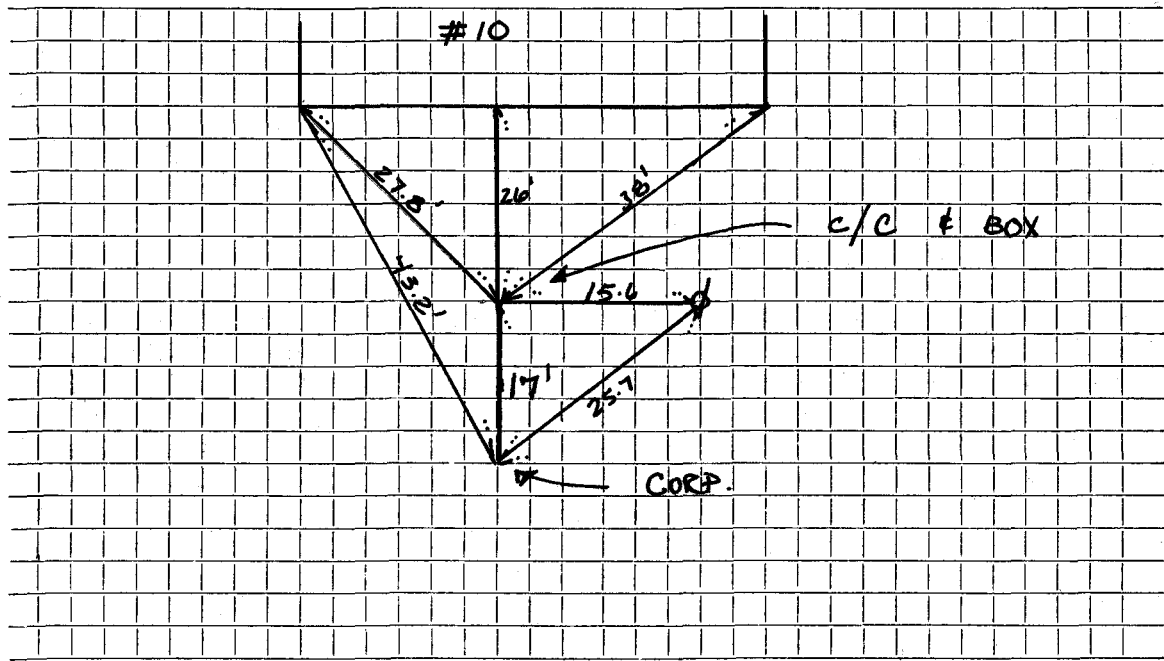

Connection made in N. HANCOCK Street. Work completed

Remarks: INSPECTED: G.T. SAMAHA

CONTRACTOR: BRUCE MCKEE

5.5' deep @ CORP.