

WATER SERVICE RECORD

Name

Michael Maurks

Service No.

Address

101 N. HANCOCK ST.

Location

Repair Renewal New Service

Valve #0247


Date	Material	Amount	Total	Date	Amount
6/22/93	35' LF 1" COPPER				
				5-25-93	
				12' 3/4" Copper	
				1 3/4" Corp Adapter	
				1 Copper-Iron Adapter	
				1 3/4" Comp Curb	
				1 Box + Rod	

DATE 1/6/94

TOWN OF LEXINGTON — BOARD OF PUBLIC WORKS

WATER DIVISION

Sketch of Service Here

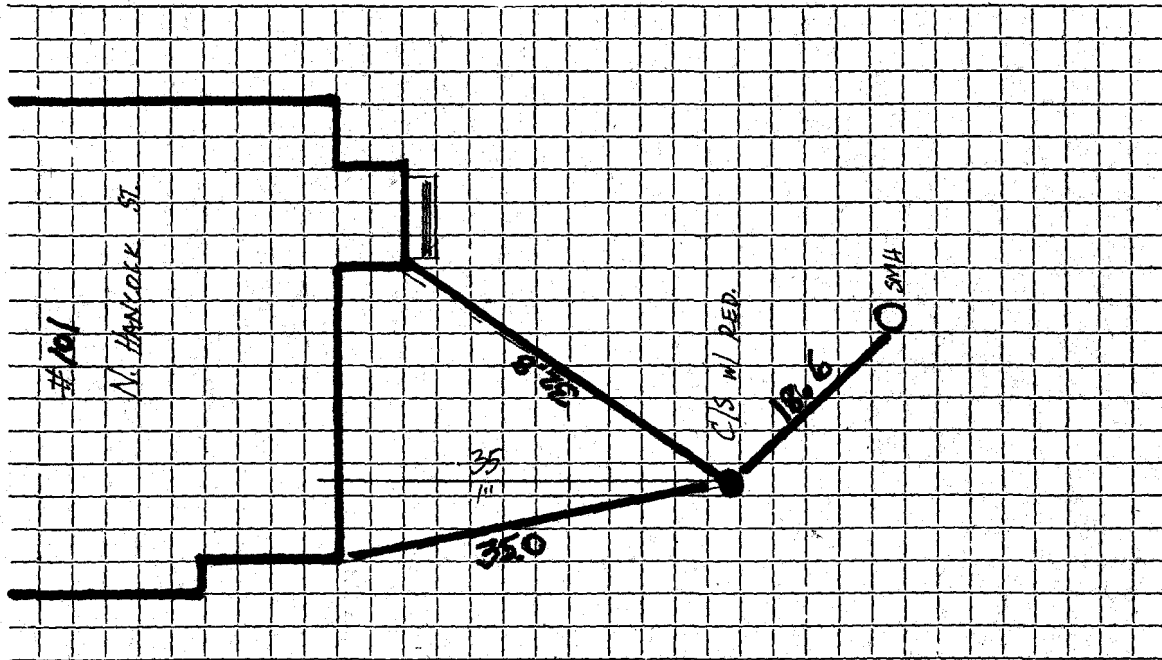

Connection made in Street. Work completed 6/22/93..... VALERI.....

Remarks:

.....

.....