

WATER SERVICE RECORD

2146
Service No. 237

Name William Sullivan

Address 103 North Hancock Street.

Location


~~Repair~~ ~~Work~~ New Service

Comm 11-30-59

Date	Material	Amount	Total	Date	Amount	
9-24-59	Labor	1 85		9-23-59	Deposit	50 00
	10% O. H.	19	2 04	11-2-59	Returned	22 58
45'	3/4" Copper tubing @.41		18 45			27 12
1	3/4" C x 1/2 I.W.H. Stop & Waste	5 88			NON CHARGE	
1	Hr. Trucking @.75		75	9-24-59	Labor	1 85
			27 12	10'	3/4" Copper tubing @.41	4 10
				1	3/4" C Corp Cock	4 67
				1	3/4" C Curb Cock	5 98
				1	1/2 Straight Tailpiece	50
				1	1/2 Offset Tailpiece	50
						17 60

TOWN OF LEXINGTON — BOARD OF PUBLIC WORKS
WATER DIVISION

Sketch of Service Here

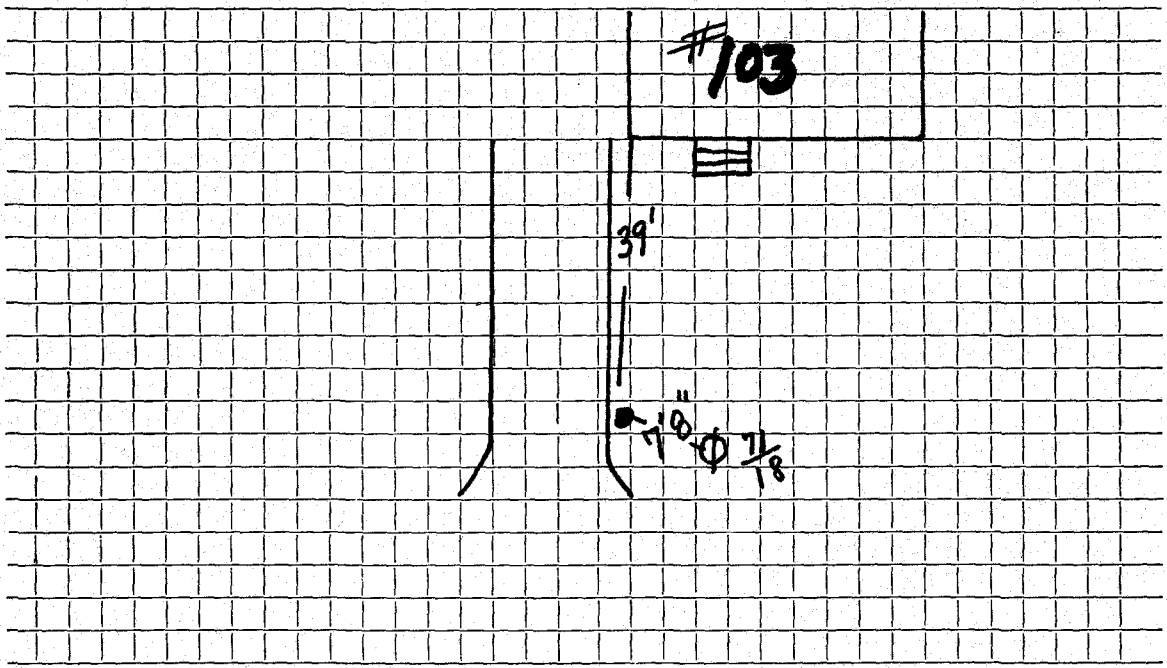

Connection made in Street. Work completed

Remarks:
.....
.....