

WATER SERVICE RECORD

Name Moore Realty Trust

Service No. 19

Address 106 North Hancock Street

2542

Location

~~Water Service~~ - New Service W.O. #7831


Comm 6-3-63

Date	Material	Amount	Total	Date	Amount
4-29-63	Labor	2.13		4-9-63	Deposit 50.00
	10% O.H.	.21	2.34	6-3-63	Refund 2.96
86'	3/4" Copper tubing @.42		36.12		47.04
1	3/4" C x 1/2 I.W.H Stop & Waste		6.17		NON CHARGE
1	3/4" C 3 part union		2.61	4-29-63	Labor 2.13
			47.04	12'	3/4" Copper tubing @.42 5.04
				1	3/4" C Corp Cock 4.91
				1	3/4" C Curb Cock 6.28
				1	Box & Rod 4.90
				1	1/2 Straight tailpiece .50
				1	1/2 Offset tailpiece .50
					24.26

TOWN OF LEXINGTON — BOARD OF PUBLIC WORKS

WATER DIVISION

Sketch of Service Here

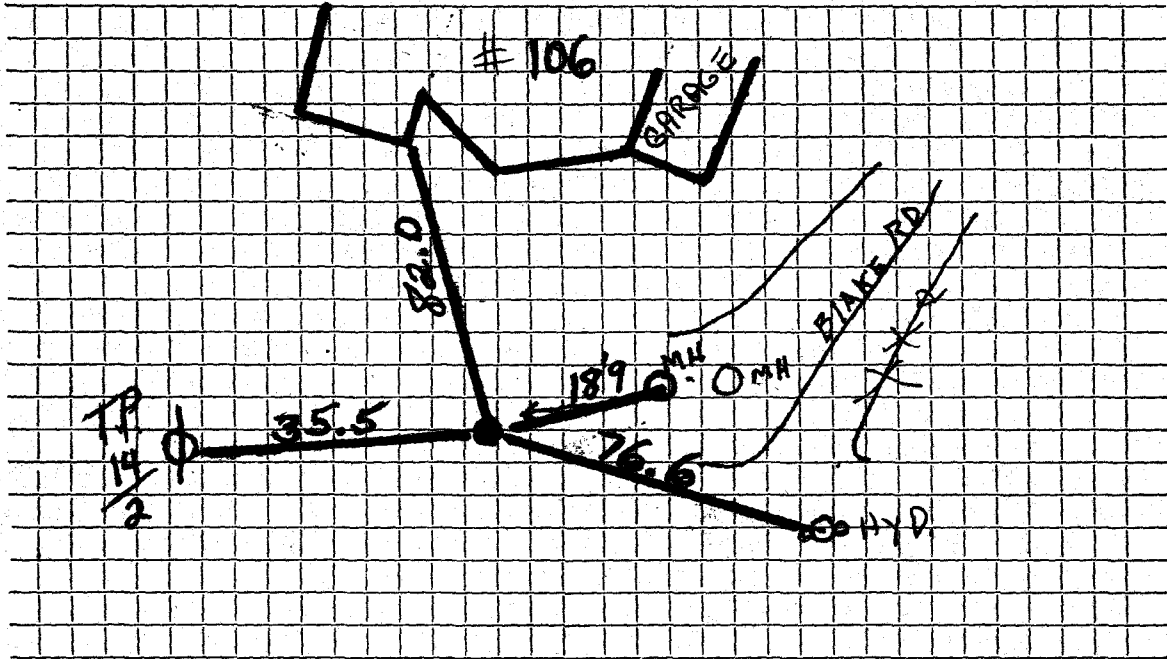

Connection made in Street. Work completed

Remarks:

.....
.....