

Name John McCullough

Service No.

2042

Address 20 North Hancock Street

Lexington, Mass.

Location 20 North Hancock Street

Kind of Pipe

Size

Size of Main

~~Repair~~ Renewal ~~New Service~~

Com 12/31/47

Location

Date	Material	Amount	Total	Date	Location	Amount
Dec. 1, '47	Labor	1 05	1 05	Nov. 19 '47	Deposited	25 00
	10% Overhead		11	Dec. 31 '47	Refunded	3 74
	60' - 3/4" Copper Tubing @ .27		16 20			21 26
	1 - 3/4" C x 1/2" I.W.H. S & W		3 15		Non-Charge	
	Trucking 1 hr. @ .75		75	12/1/47	Labor	1 05
			21 26	22' 3/4" Copper Tubing @ .26		5 72
				1 3/4" C. Corp. Cock		3 00
				1 3/4" C.x3/4" C. Curbcock		3 68
				1 3/4" Cx3/4" C Union (8 pts)		1 32
				1 Box and Rod		4 26
				1 hr. Trucking		75
				1 1/2" Offset Tail piece		30
	Labor			1 1/2" Str. Tail Piece		30
				Patching 3x2		2 00
						22 38

TOWN OF LEXINGTON - BOARD OF PUBLIC WORKS

WATER DIVISION

The undersigned applies for a supply of water at No..... St. and hereby agrees to comply with the rules and regulations as now, or at any future time, established by the Board of Selectmen.

Am't of Estimate \$.....


Owner

Am't Paid \$.....

Address

Builder

Sketch of Service Here

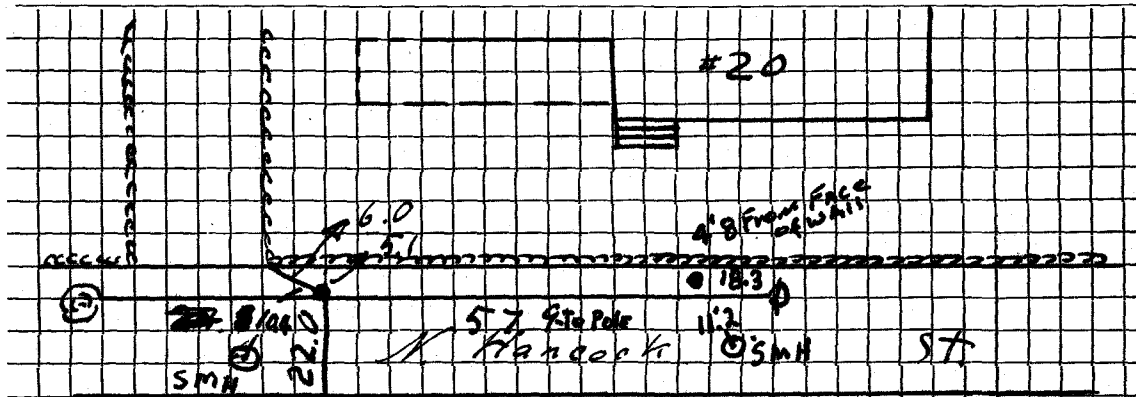

Connection made in Street.

↑ Work completed19

Remarks:

OLD SERVICE
DEAD ? MAY BE CEMENTED OVER FROM RELINEING