

Name Perley C. Tibbetts

Service No. ~~2045~~ 2045

Address 62 Reed Street

2697

23 No. Hancock St.

Location 23 No. Hancock St.

Kind of Pipe

Size

Size of Main

Repair—Renewal—New Service

Location

Date	Material	Amount	Total	Date	Amount
6-16-31 for 66-00	44' 1" C.L. Pipe @.27	\$11 88		Aug. 25 1931 - Cash checked 5-3-23 Outside 3/4 Cop.	66 -
	2 1" L.L. Coup. @.30	60			
	2 1" L.L. Ells @.35	70			
	2 1" Br. Sp. Nip. @.25	50			
	1 S & W Trucking	3 00 75	17 43		
6-2/31	37 Hrs. Labor @.55	20 35			
	2 " " @.60	1 20	21 55		
	15% Overhead		3 23		
<u>COST</u>			42 21		
	Labor				
CHARGE	44' @ \$1.50	\$66 00	\$66 60		

Hadley Press, Inc. Lexington

DATE May 28, 1931

TOWN OF LEXINGTON—BOARD OF PUBLIC WORKS

WATER DIVISION

The undersigned applies for a supply of water at No. 23 Wansuck St. and hereby agrees to comply with the rules and regulations as now, or at any future time, established by the Board of Selectmen.

Am't. of Estimate \$ _____

Owner

Perley C. Tibbets


Am't. Paid \$ _____

Address

62 Reed St.
Lex.

Builder _____

Sketch of Service Here

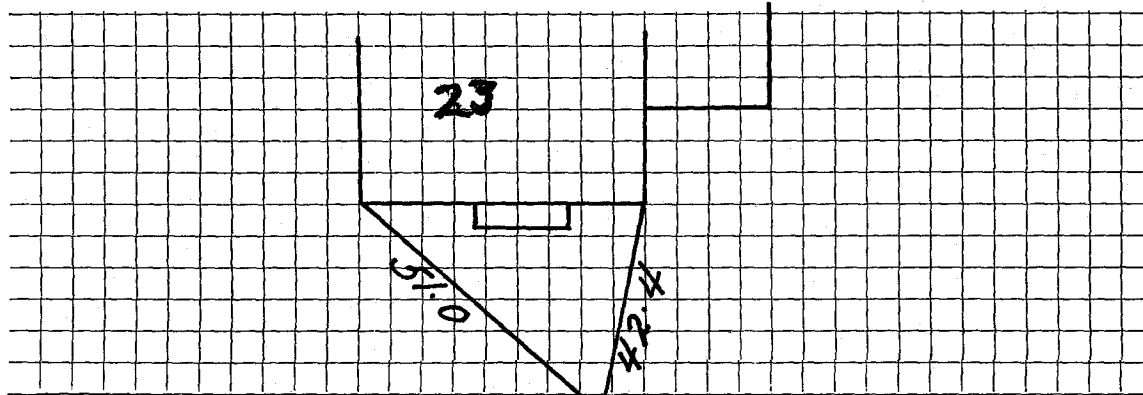

Connection made in _____ Street.

Work completed _____ 19

Remarks: