

WATER SERVICE RECORD

Name Dillavou

Service No.

Address 25 NORTH HANCOCK ST.

Location

Repair Renewal ~~New Service~~

Rockwell Construction Co., Inc. #0378


Date	Material	Amount	Total	Date	Amount
1/10/95	50 LF 1" COPPER				
5-31-94	4' 3/4" Copper			9-24-48	10' 3/4" Copper
	1 1" M X 3/4" Compression				1 3/4" C. Adapter
	1 1" I. X 3/4" Comp.				1 3/4" C. X 3/4" C. Curb Cock
	1 3/4" Comp Curb				1 3/4" C.L. 6" Nipple
	1 3/4" Comp Curb				1 3/4" Repair Clamp
	1 I X I F Coupling				

DATE 1/10/95

TOWN OF LEXINGTON — BOARD OF PUBLIC WORKS

WATER DIVISION

Sketch of Service Here

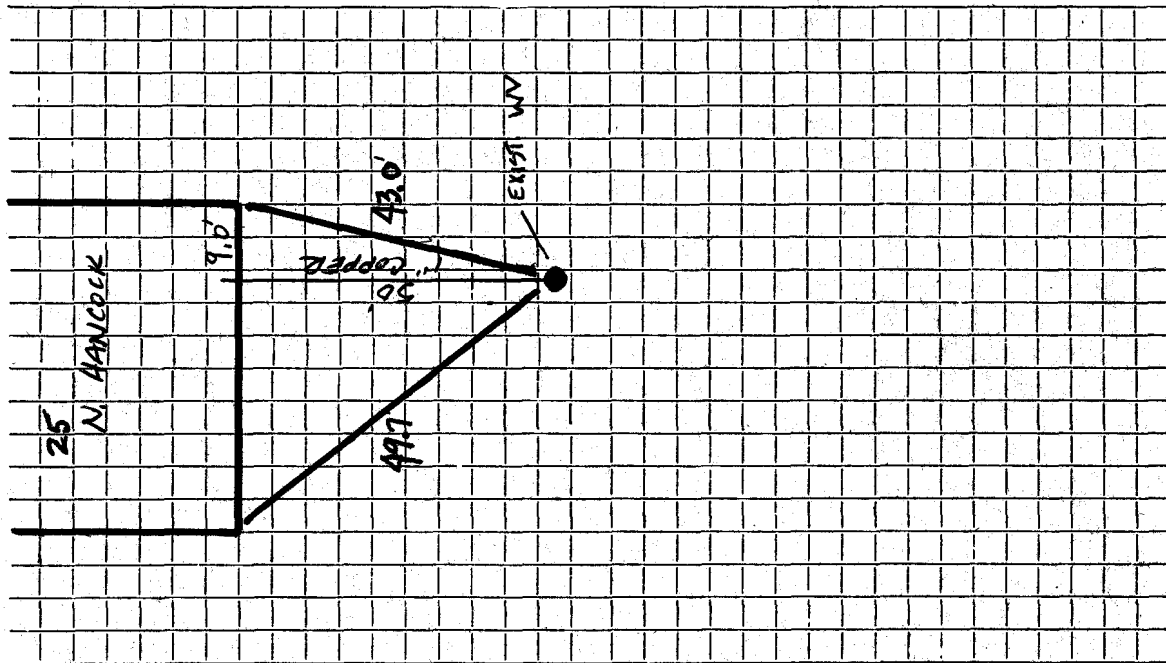

Connection made in Street. Work completed

Remarks:
.....
.....