

WATER SERVICE RECORD

Name Walter A. Kmiec

Service No. 37

Address 27 No. Hancock Street

Location

~~Repair~~ ~~Renewal~~ ~~New Service~~ W. O. # 8235

JAN 17 1972


Date	Material	Amount	Total	Date	Amount
11/8/71	Labor	63 76		10-29-71	Deposit 250 00
	10% O.H.	6 38	70 14	1-17-72	Refund 134 53
	43' = 3/4" Copper pipe .79		33 97		129 41
	1-3/4" Wheel Valve		9 30		<u>OUTSIDE</u>
	1-Hr. Trucking		3 00	11/8/71	Labor 22 57
	2-Hrs. Shovel @ 6.50		13 00	1/2	Ton hot top 7.45 3 73
			129 41	1/2	Hr. Trucking 3.00 1 50
				1/2	Hr. Compressor 3.00 1 50
				1/2	Hr. Roller 2.00 1 00
					Trailer 2 00
				7-23-54	15' 1" COPPER 32 30
					1 1" CORP
					1 1" Curb Cock
					Box + Rod

DATE _____

TOWN OF LEXINGTON — BOARD OF PUBLIC WORKS

WATER DIVISION

Sketch of Service Here

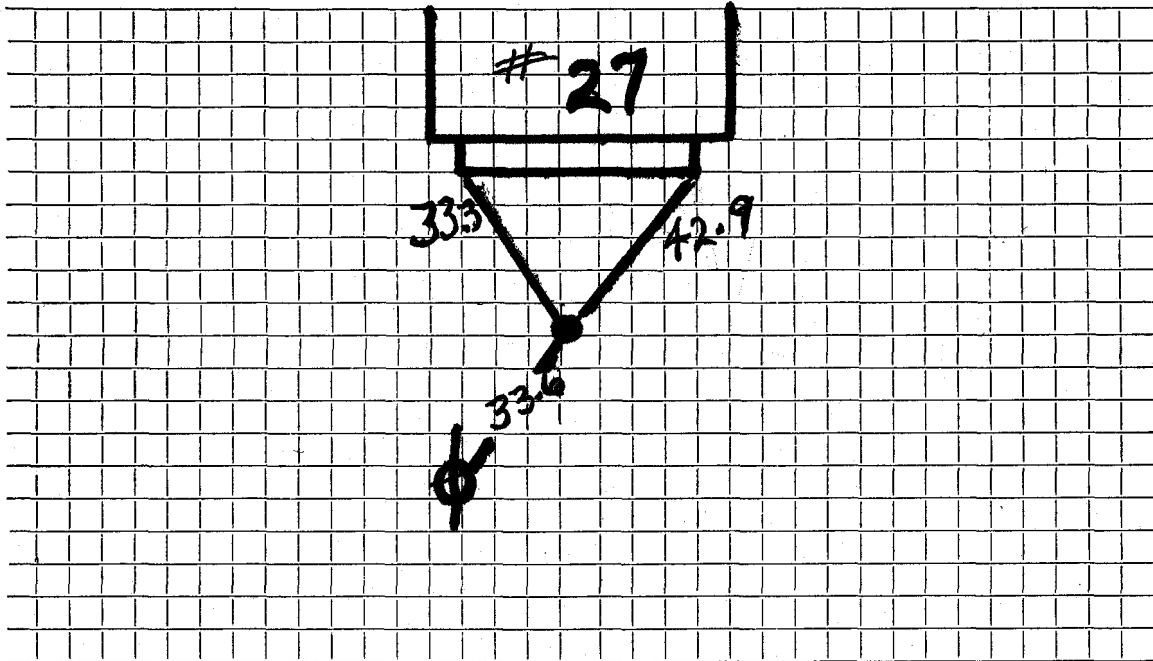

Connection made in Street. Work completed

Remarks:
.....
.....