

WATER SERVICE RECORD

#5183  
#6538

Name Charles A. McCormack

Service No. 70

Address 35 North Hancock St.

Location Lexington

~~RENEWAL - NEW SERVICE~~

COM. 6-8-53


Date	Material	Amount	Total	Date	Amount
5/20/53	Labor	1 75		4-10-53	<i>Deposited</i> 25 00
	10% overhead	18	1 93	6-8-53	<i>Refunded</i> 5 40
	38'-3/4" Copper Tubing @.34		12 92		NON CHARGE 19 60
	1-3/4" C x 1/2 I.W.H. STOP & WASTE		4 00	5/20/53	Labor 1 75
	1 Hr. Trucking		75		10'-3/4" Copper Tubing @.34 3 40
			19 60		1-3/4" C. Corp-cock 4 33
					1-3/4" C x 3/4" C. Curb-cock 4 67
					1-Box & Rod 3 90
					1-1/2 offset tail piece 50
					1-1/2 straight tail piece 50
					1 Hr. Trucking 75
					<u>19 80</u>

DATE \_\_\_\_\_

TOWN OF LEXINGTON — BOARD OF PUBLIC WORKS

**WATER DIVISION**

Sketch of Service Here

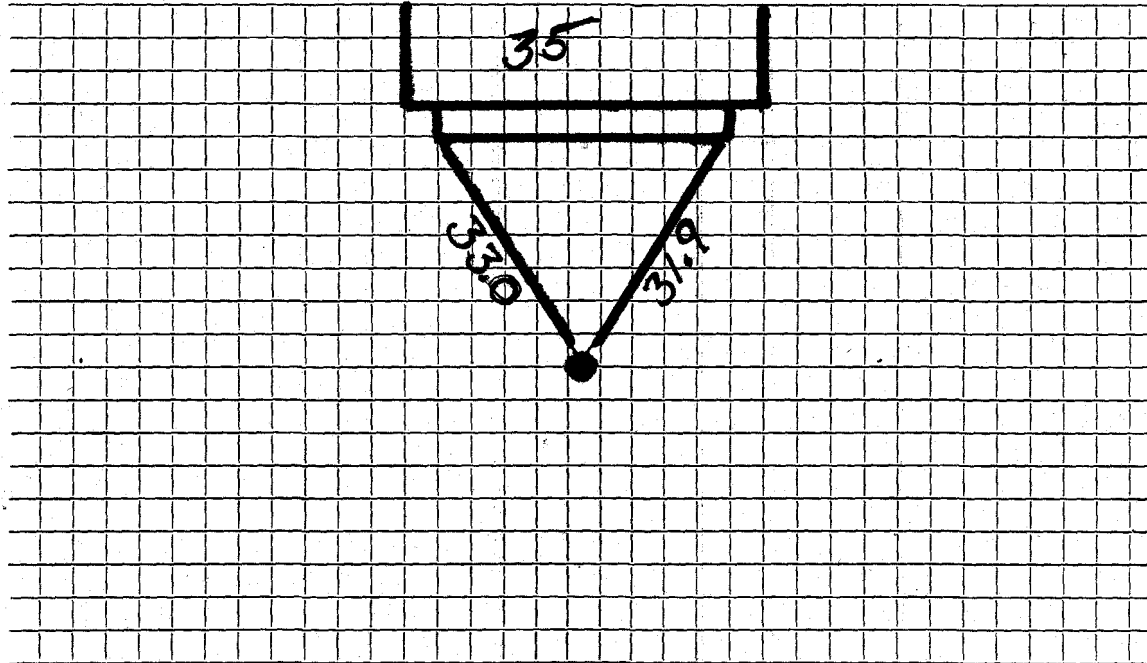

Connection made in ..... Street. Work completed .....

Remarks: .....

.....

.....