

WATER SERVICE RECORD

5108

Name Leonard Colwell

Service No. 63

Address 36 North Hancock Street

Location

~~Repair~~—Renewal—~~New Service~~ W.O. #614


MAR 14 1966

Date		Material	Amount		Total		Date		Amount	
7-8-65		Labor	71	63			7-6-65	Deposit	200	00
		10% O.H.	7	16	78	79	3-14-66	Retard	.31	82
70'		3/4" copper tubing @ .42			29	40			168	18
1		3/4" wheel handle			9	29				
1		Union			1	80				
5		Yds. Loam @3.00			15	00				
2		Lbs. Grass seed @ .95			1	90				
2		Hrs. Town Truck @ 3.00			6	00				
4		Hrs. Tractor @ 6.50			26	00				
					168	18				

DATE _____

TOWN OF LEXINGTON — BOARD OF PUBLIC WORKS
WATER DIVISION

Sketch of Service Here

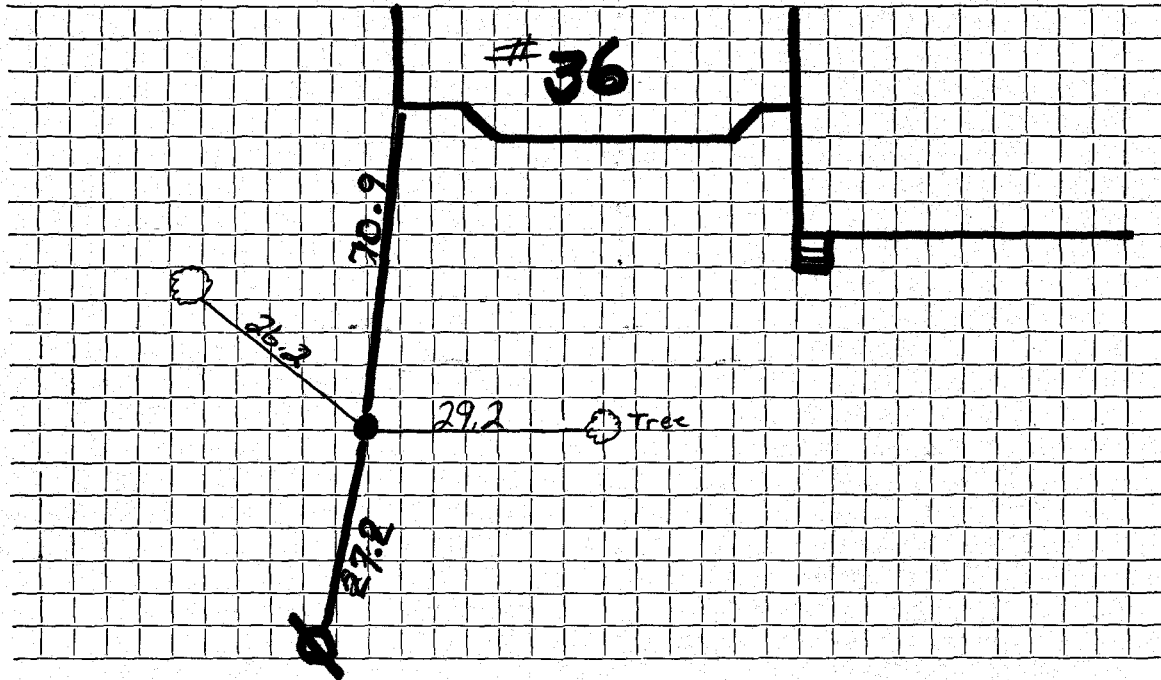

Connection made in Street. Work completed

Remarks:

.....

.....