

## WATER SERVICE RECORD

Name Robert S. Weaver

Service No. 2

Address 45 North Hancock Street

Location

~~Repair~~—Renewal—~~NEW SERVICE~~ W.O. #3003

FEB 10 1975


Date	Material	Amount	Total	Date	Amount	
1-22-75	Labor	95.66		1-25-75	Deposit	225.00
	10 % O.H.	9.57	\$105.23	2-10-75	Retund	32.30
	31' 3/4" Copper pipe	@1.05	32.55		Renew out	192.70
1	3/4" Wheel Valve		15.43	4-11 73	9'-3/4" COPPER	
1	Ground Clamp		.49		1 - 3/4 Curb Cock	
	Loam and Seed		20.00		1 - 3/4" COPPER ADPT	
2	Hrs. Trucking	@3.00	6.00			
2	Hrs. Backhoe	@6.50	13.00			
			\$192.70			

DATE \_\_\_\_\_

# TOWN OF LEXINGTON — BOARD OF PUBLIC WORKS

## WATER DIVISION

Sketch of Service Here

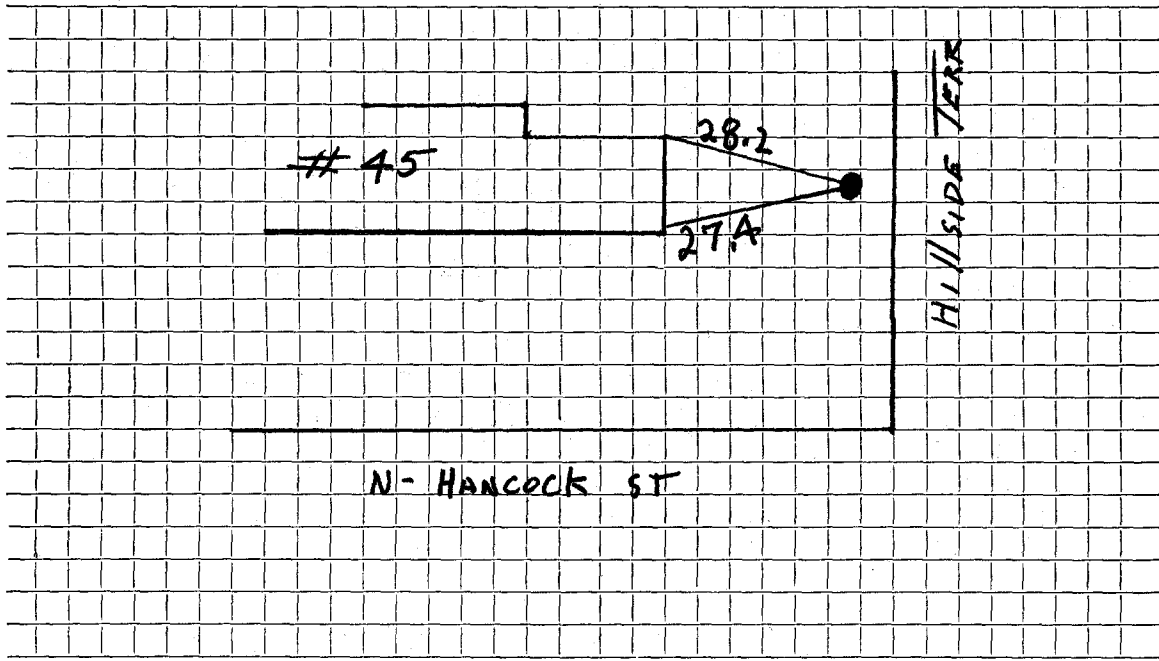

Connection made in ..... Street.      Work completed .....

Remarks: .....  
.....  
.....