

WATER SERVICE RECORD

Name David Acker

Service No. 296 (1956)

Address 49 North Hancock Street

1799

Location

~~Repair~~—Renewal—~~New Service~~

Comm. 2-25-57


Date	Material	Amount	Total	Date	Amount
10/27/56	Labor	63 97		9-21-56	Deposit # 125 00
	10% Overhead	6 40	70 37	3-5-57	Paid 18 51
	55' - 3/4" Copper tubing @ .4396	24 18			NON CHARGE \$ 143 51
	1 - 3/4" Cx 1/2 I.W.H. Stop & Waste	4 96			Labor 6 60
	2 hrs. Trucking @ .75	1 50			10' - 3/4" Copper tubing @ .4396 4 40
	5 hrs. Littlefield Shovel @ .85	42 50			1 - 3/4" C. Corp Cock 4 64
			143 51		1 - 3/4" C. Curb Cock 5 94
					1 Box & Rod 4 62
					1 - 1/2 Offset tailpiece 50
					1 - 1/2 Straight tailpiece 50
					1 hr. Littlefield Shovel 8 50
					<u>35 70</u>
					Bill sent 2-27-57

DATE _____

TOWN OF LEXINGTON — BOARD OF PUBLIC WORKS

WATER DIVISION

Sketch of Service Here

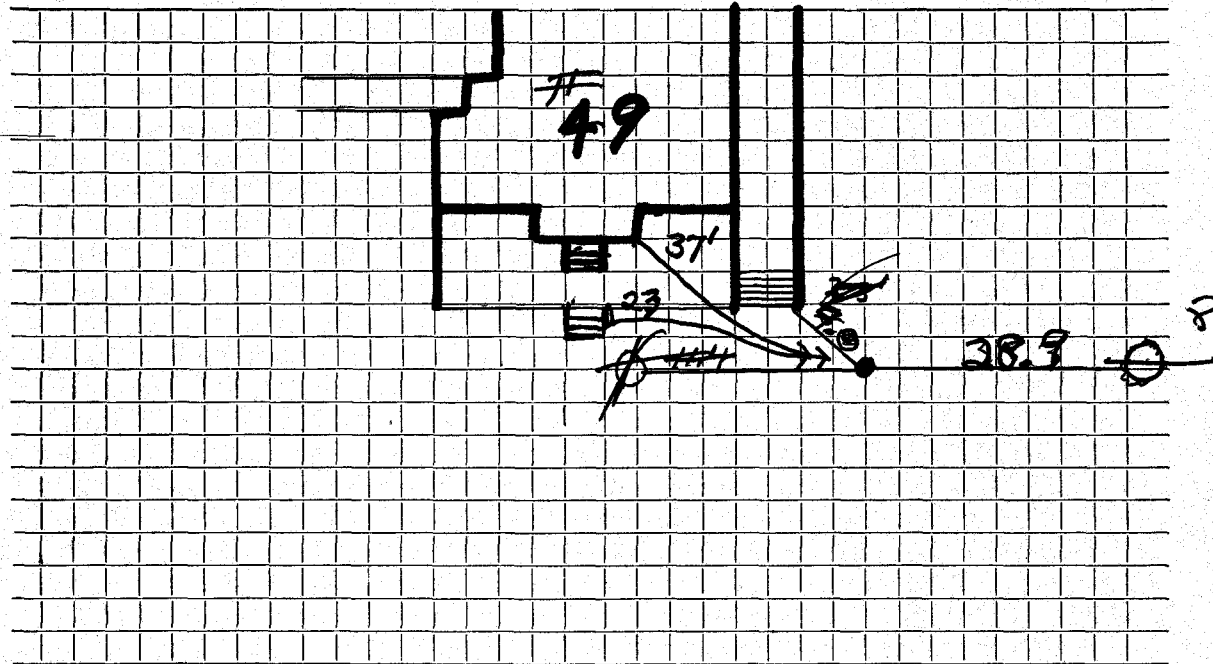

Connection made in Street. Work completed

Remarks:

.....

.....