

## WATER SERVICE RECORD

#5126

Name Joseph F. Clark

Service No. 48

Address 52 North Hancock Street

# 6957

Location

~~RENEW~~ - Renewal - ~~NEW SERVICE~~

WO #7206


Comm 7-16-62

Date	Material	Amount	Total	Date	Amount	
5/14/62	Labor	80 81		5-9-62	Deposit	250 00
	10% O.H.	8 08	88 89	7-16-62	Refund	27 85
	78' 1" Copper Tubing @ .56		43 68			172 15
	1 1" Cx3/4" IWH Stop & Waste		6 96			
	1 3/4 x 1/2 Bushing		64		Curb to Main	
	1 1" 3 Part Union		3 98	5/15/62	Labor	23 77
	4 Hrs. Town Shovel @ 5.50		22 00		9' 1" Copper Tubing @ .56	5 04
	2 Hrs. Trucking @ 3.00		6 00		1 1" C Corp Cock	7 31
			<u>172 15</u>		1 1" Curb Cock	8 06
					1 Bow & Rod	4 90
					1 Hr. Town Shovel @ 5.50	5 50
					1 Hr. Trucking @ 3.00	3 00
					3 X 7 Patch	<u>7 00</u>
						64 52

TOWN OF LEXINGTON — BOARD OF PUBLIC WORKS

WATER DIVISION

Sketch of Service Here

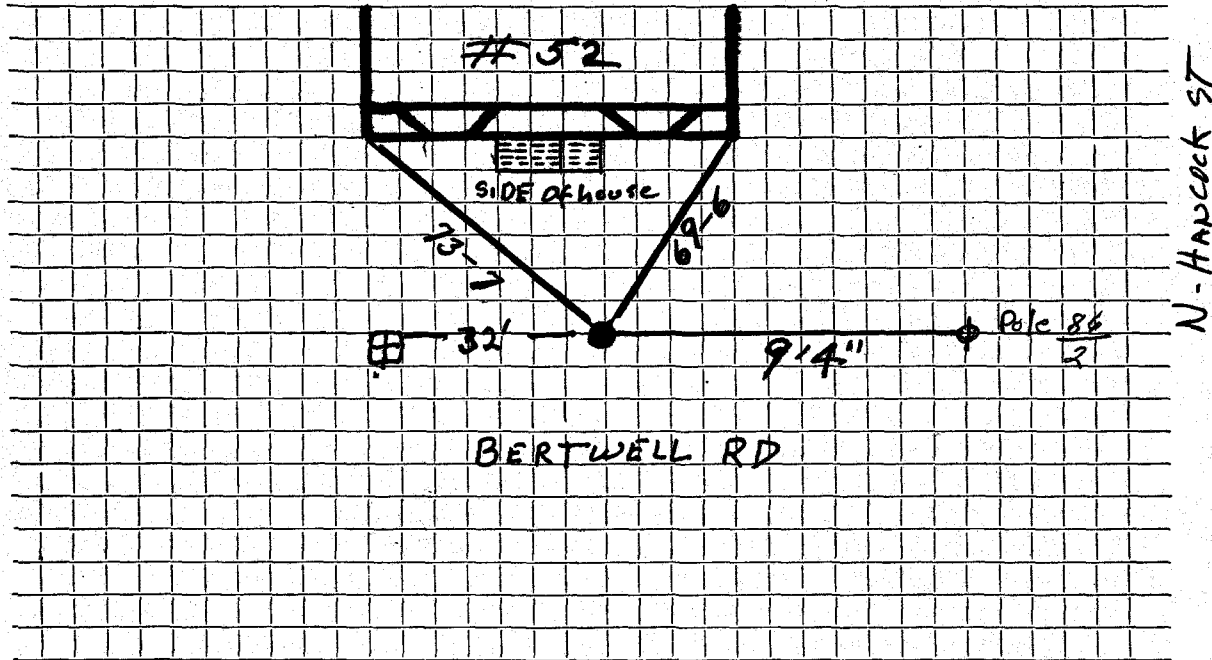

Connection made in Bertwell RD ..... Street.      Work completed .....

Remarks: .....

.....

.....