

WATER SERVICE RECORD

2340
Service No. 297

Name Compton Brothers

Address 55 North Hancock Street

Location Lexington, Massachusetts

~~Repair/Removal~~—New Service

Com. 12-26-50


Date	Material	Amount	Total	Date	Amount
				Sept 13 '50	25 00
Oct. 25 '50	Labor	1 35	1 35	<i>Deposited</i>	11
	10% Overhead		14	No Charge	24 56
	58' - 3/4" Copper Tubing @.32		18 56	Oct. 25, '50 Labor	1 35
	1 - 3/4" C x 1/2" I.W.H.S&W		3 76	7' - 3/4" Copper Tubing @.32	2 24
	Trucking 1 hr. @.75		75	1 - 3/4" Corp-cock	3 60
			24 56	1 - 3/4" C x 3/4" C Curb-cock	4 40
				1 - Box & Rod	3 35
				1 - 1/2" Offset Tail Piece	42
				1 - 1/2" Straight Tail Piece	42
				Trucking 1 hr. @.75	75
					16 53

DATE _____

TOWN OF LEXINGTON — BOARD OF PUBLIC WORKS

WATER DIVISION

Sketch of Service Here

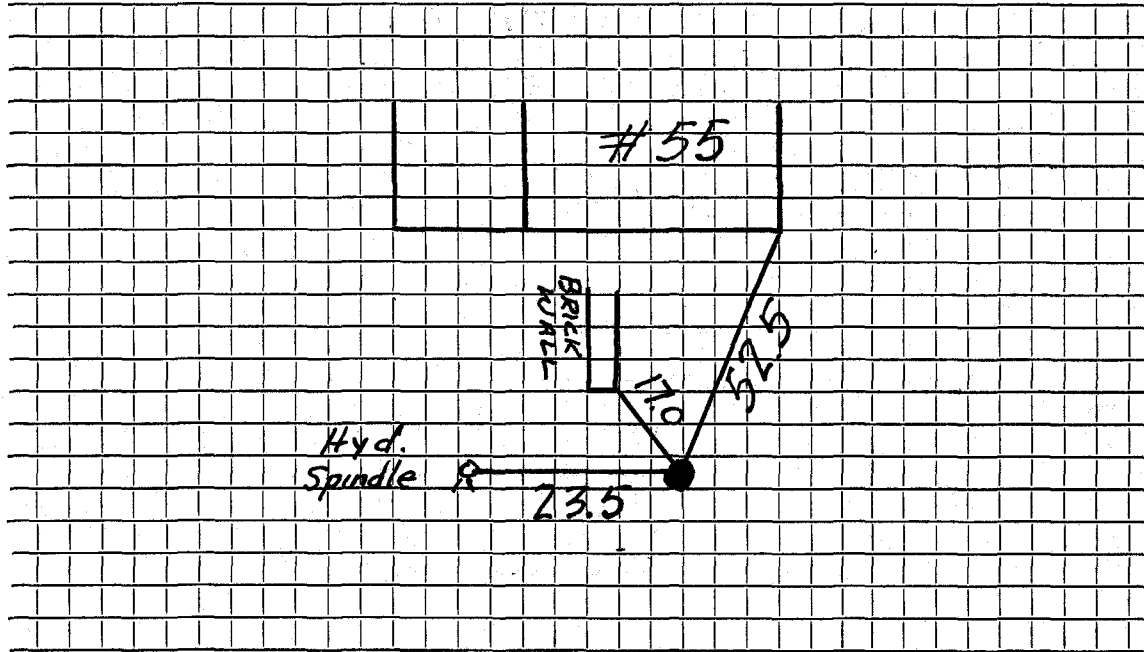

Connection made in Street. Work completed

Remarks:
.....
.....