

WATER SERVICE RECORD

Name

Marie T. Faskett

Service No.

266

Address

59 N. Hancock St.

Location

~~Repair~~ ~~Renewal~~ ~~New Service~~ Renewal

Com. 12-13-54


Date	Material	Amount	Total	Date	Amount
11/15/54	Labor	10 55		10-20-54 Deposited	25 00
	10% overhead	1 06	11 61	12-13-54 Refunded	37 42
	70' - 3/4" copper tubing @.35	24 50		NON CHARGE	57 58
	1-3/4 C. x 1/2 I.W.H. stop & waste	4 00		11/15/54 Labor	9 00
	1-3/4 C. x 3/4 C. Union (3 parts)	1 72		10' 3/4" copper tubing @.35	3 50
	6 hr. Littlefield shovel @7.50	45 00		1-3/4 C. corp-cock	4 33
	1 hr. trucking		75	1-3/4 C. curb-cock	4 67
			87 58	1- box & rod	3 90
9-22-'59	Repair			1-1/8 offset tail pc.	50
	9' 3/4" Copper			1-1/2 straight tail pc.	50
	1 3/4" C. 3 Part Union			2/3 hr. Littlefield shovel @ 7.50	5 00
	1 1" Style 38 Clamp			1 hr. trucking	75
	1 1" X 6" C. L. Nipple			Patching 1/4x3	4 00
					36 15

DATE _____

TOWN OF LEXINGTON — BOARD OF PUBLIC WORKS

WATER DIVISION

Sketch of Service Here

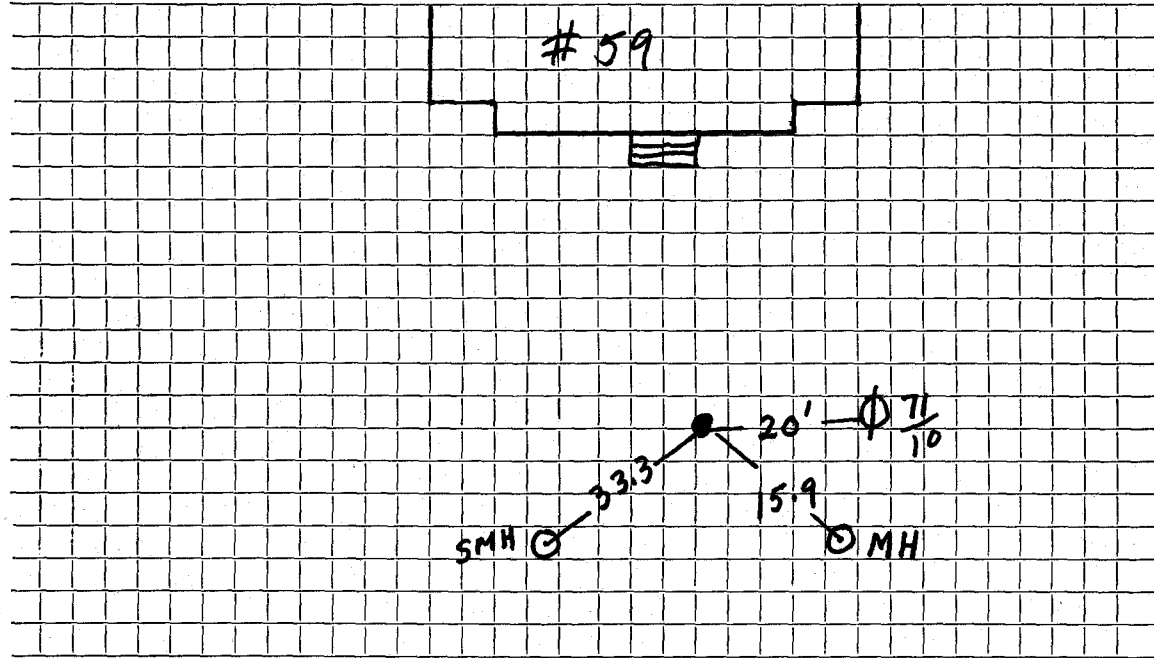

Connection made in Street. Work completed

Remarks:

.....

.....