




TOWN OF LEXINGTON — BOARD OF PUBLIC WORKS

WATER DIVISION

Sketch of Service Here

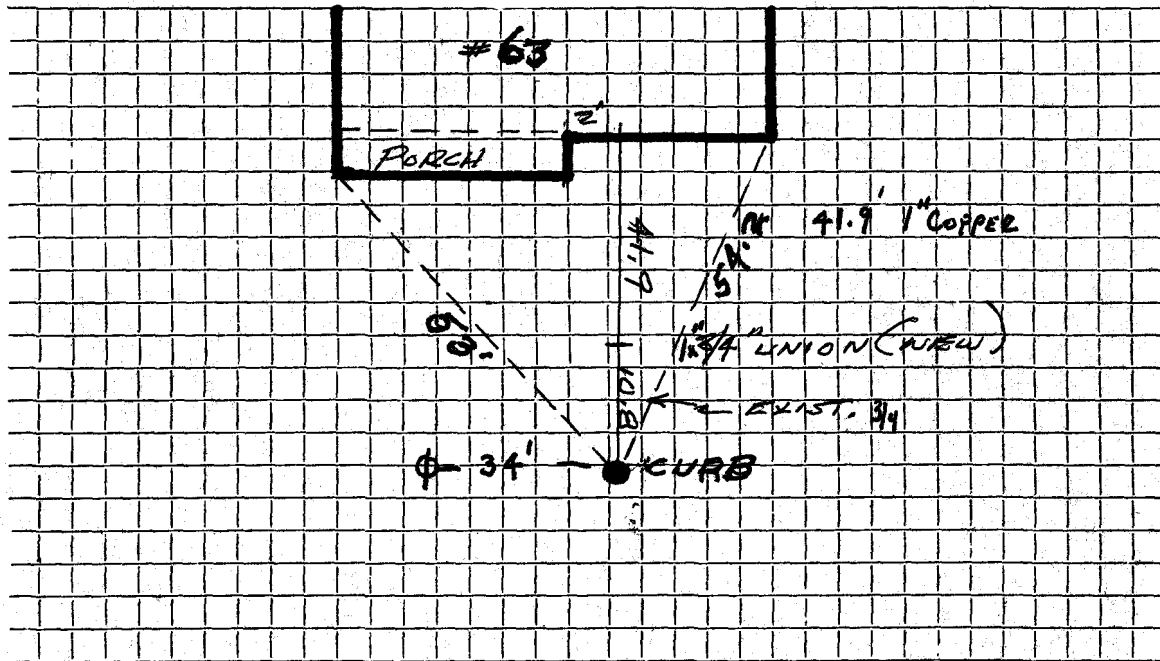

Connection made in N-HANCOCK Street. Work completed .....

Remarks: CONN. MADE TO EXIST. COPPER .....