

WATER SERVICE RECORD

Name Jessamy Patterson

Service No.

Address 67 No. Hancock Street

Location

~~Repair~~ ~~Renewal~~ ~~New Service~~ Dave Eagle #3719


Date	Material	Amount	Total	Date	Material	Amount	Total
8/27/81	56' 3/4" Copper tubing						
	1 3 part Union						
	1 Wheel Valve						
					OUTSIDE		
				9/23/59	9' 3/4" Copper tubing @ .42		\$ 3.78
					1 3/4" Adapter		2. 10
					1 3/4" Curb Cock		5. 98
					1 Box & Rod		4.90
					1 hr. Trucking @ .75		.75
					1 hr. Town Shovel @ 6.50		6. 50
							\$41. 14

DATE _____

TOWN OF LEXINGTON — BOARD OF PUBLIC WORKS

WATER DIVISION

Sketch of Service Here

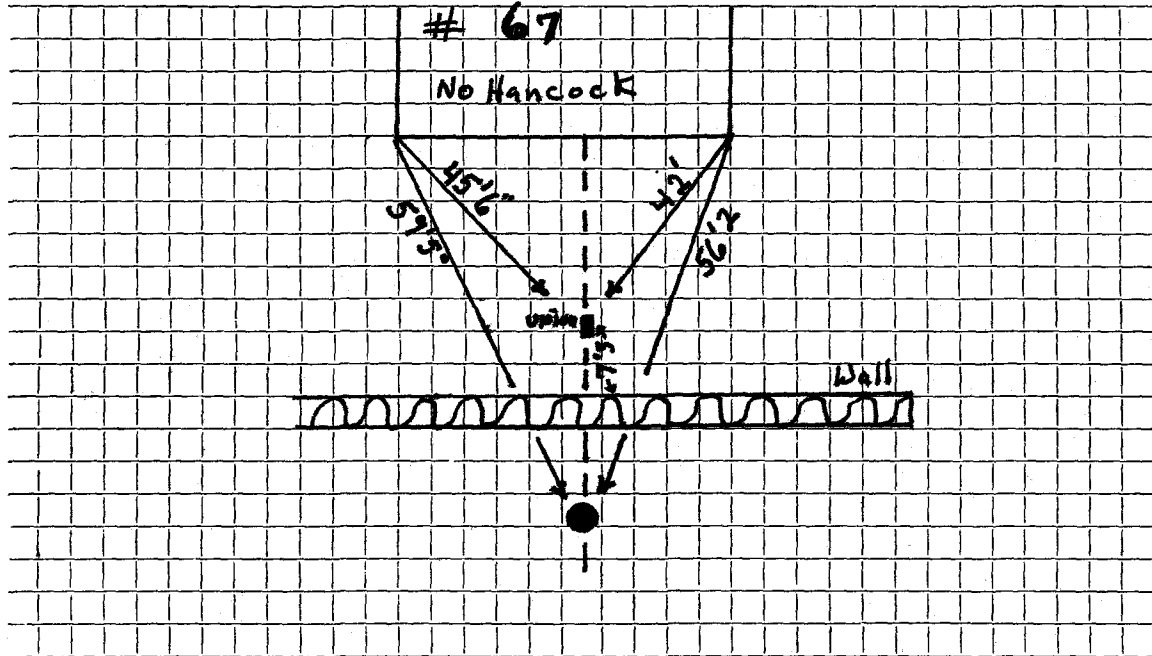

Connection made in Street. Work completed

Remarks:
.....
.....