

Name James Sullivan

Service No. 98

Address 81 North Hancock Street

Lexington, Mass.

Location 81 North Hancock Street

Kind of Pipe

Size

Size of Main

~~REPLACEMENT~~—New Service

Com. 7-3-50

Location

Date	Material	Amount	Total	Date	Amount
May 29' 50	Labor	1 50	1 50	May 16 '50	Deposited 30 00
	10% Overhead		15	July 20 '50	Reimbursed 1 50
	59' - 3/4" Copper Tubing @.23		13 57		No Charge 19 26
	1 - 3/4"C x 1/8" I.W.H. S&W		3 29	May 29, '50	Labor 1 50
	Trucking 1 hr. @.75		75	10' - 3/4" Copper Tubing @.23	2 30
			19 26	1 - 3/4"C Corp-cock	3 15
				1 - 3/4"C x 3/4"C Curb-cock	3 85
				1 - Box & Rod	3 35
				1 - 1/2" Offset Tail Piece	38
				1 - 1/2" Straight Tail Piece	38
				Trucking 1 hr. @.75	75
					15 66
	Labor				

DATE \_\_\_\_\_

# TOWN OF LEXINGTON - BOARD OF PUBLIC WORKS

## WATER DIVISION

The undersigned applies for a supply of water at No..... St. and hereby agrees to comply with the rules and regulations as now, or at any future time, established by the Board of Selectmen.

Am't of Estimate \$.....

Owner .....


Am't Paid \$.....

Address .....

Builder .....

.....

Sketch of Service Here

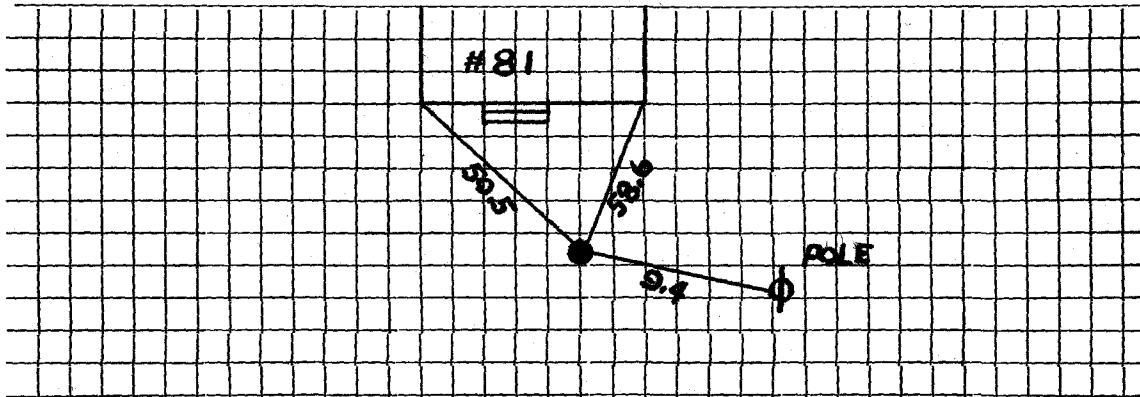

Connection made in ..... Street.

Work completed .....19

Remarks: