

**WATER SERVICE RECORD**

Name *[Blank]*

Service No.

Address *9 North Hancock Street + 265 Bedford*

Location


~~Repair~~ Renewal ~~New Service~~

Date		Material	Amount	Total	Date		Amount	
					<u>NON CHARGE</u>			
6-10-60		Labor	42				93	
		9' 3/4" Copper Tubing @.42	3				78	
		1 3/4" Adapter @1.90	1				90	
		1 3/4" Curb Cock.@6.28	6				28	
		1 1" Lead Lined Coupling@.54	54				54	
		2 Hrs. Pippin Shovel @4.56	9				12	
		2 Hrs. Trucking @3.00	6				00	
		2 Hrs. Pumping @ 1.00	2				00	
							<u>29</u>	62

# TOWN OF LEXINGTON — BOARD OF PUBLIC WORKS

## WATER DIVISION

Sketch of Service Here

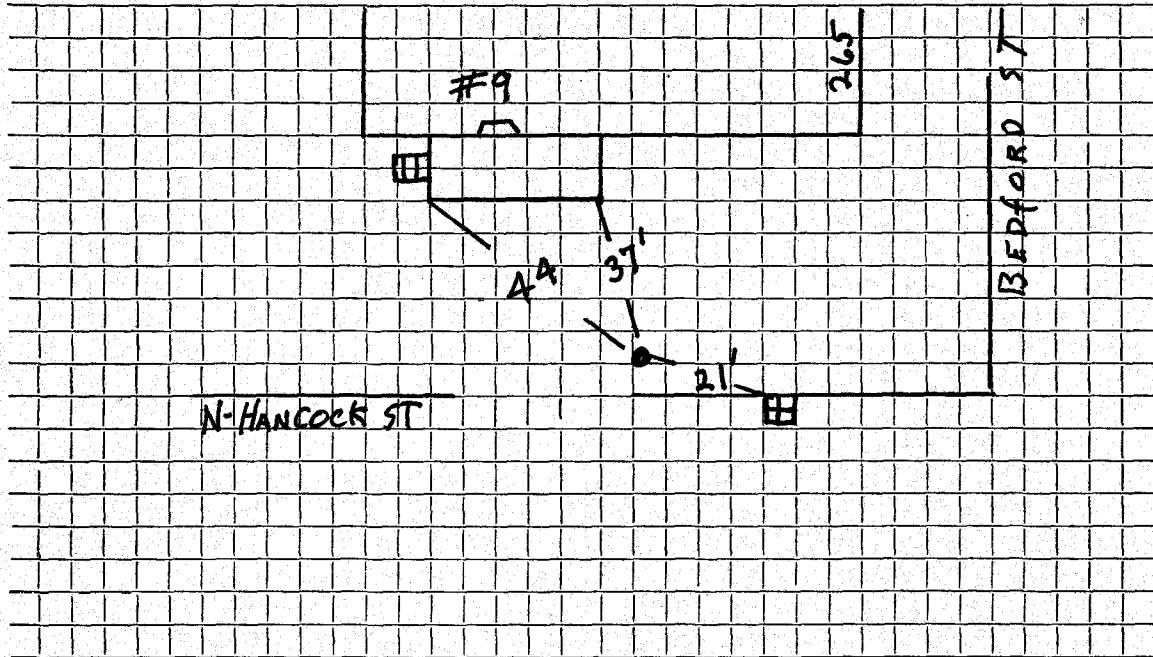

Connection made in ..... Street.      Work completed .....

Remarks: .....

.....

.....