

Name Moses M. Low

Service No.

75

Address 95 N. Hancock Street

Lexington, Mass.

Location 95 N. Hancock Street

Kind of Pipe

Size

Size of Main

RENEWAL

~~WATER MAIN SERVICE~~

Com. 6-11-49

Location

Date	Material	Amount	Total	Date		Amount
May 19, '49	Labor	2 60	2 60	May 16 '49	Deposited	25 00
	10% Overhead		26	June 24 '49	Refunded	7 54
	114' - 3/4" Copper Tubing @.24	10 56			Non-Charge	17 46
	1 - 3/4" C x 1/2" I.W.H. S&W	3 29		May 19, '49	Labor	2 60
	Trucking 1 hr. @.75		75	10' - 3/4" Copper Tubing @.24		2 40
			17 46	1 - 3/4" C Corp-cock		3 15
				1 - 3/4" C x 3/4" C Curb-cock		3 85
				1 - Box & Rod		3 95
				1 - 1/2" Offset Tail Piece		37
				Trucking 1 hr. @ .75		75
						17 07
	Labor					

DATE \_\_\_\_\_

TOWN OF LEXINGTON - BOARD OF PUBLIC WORKS

**WATER DIVISION**

The undersigned applies for a supply of water at No..... St. and hereby agrees to comply with the rules and regulations as now, or at any future time, established by the Board of Selectmen.

Am't of Estimate \$.....

Owner .....


Am't Paid \$.....

Address .....

Builder .....

.....

Sketch of Service Here

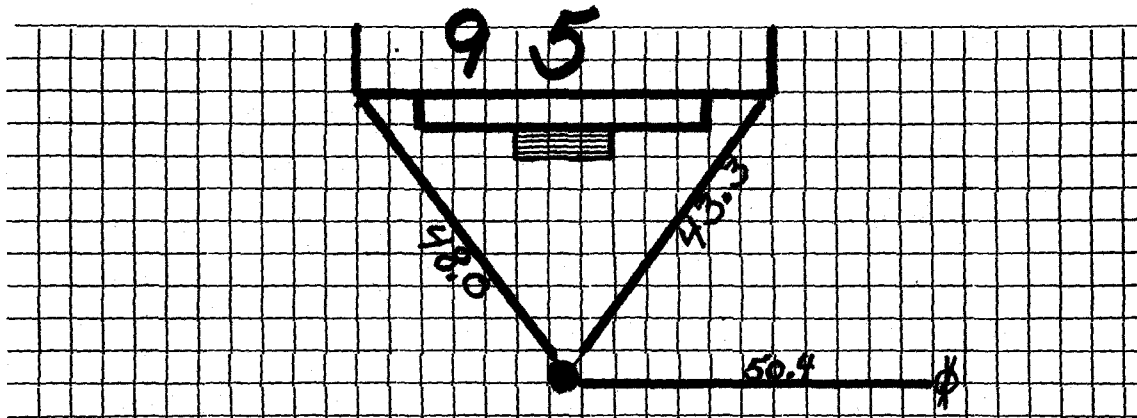

Connection made in ..... Street.

Work completed .....19

Remarks: