

WATER SERVICE RECORD

Name Norman N. Martis

Service No. 17

Address 10 1/2 North Street

Location

~~RENEWAL~~ - Renewal - ~~W.O. #2124~~ W.O. #2124

JUN 23 1966

Date		Material	Amount	Total	Date	Amount
4-18-66		Labor	87 74			
		10% O.H.	8 77	96 51	1	CURB TO MAIN
	110'	3/4" copper tubing @ .70		77 00	1	1 x 3/4 - 2 part union
	1	3/4" wheelhandle		9 29	2	1" Brass close nipple
	3	Hrs. Shovel @ 6.50		19 50	1	Tailpieces
	1	Hr. Truck		3 00	1	Box & Rod
				<u>205 30</u>	4-18-66	Deposit
					9-13-66	Paid
						200 00
						5 30
						<u>205 30</u>


Bill sent 5130

DATE \_\_\_\_\_

TOWN OF LEXINGTON — BOARD OF PUBLIC WORKS

WATER DIVISION

Sketch of Service Here

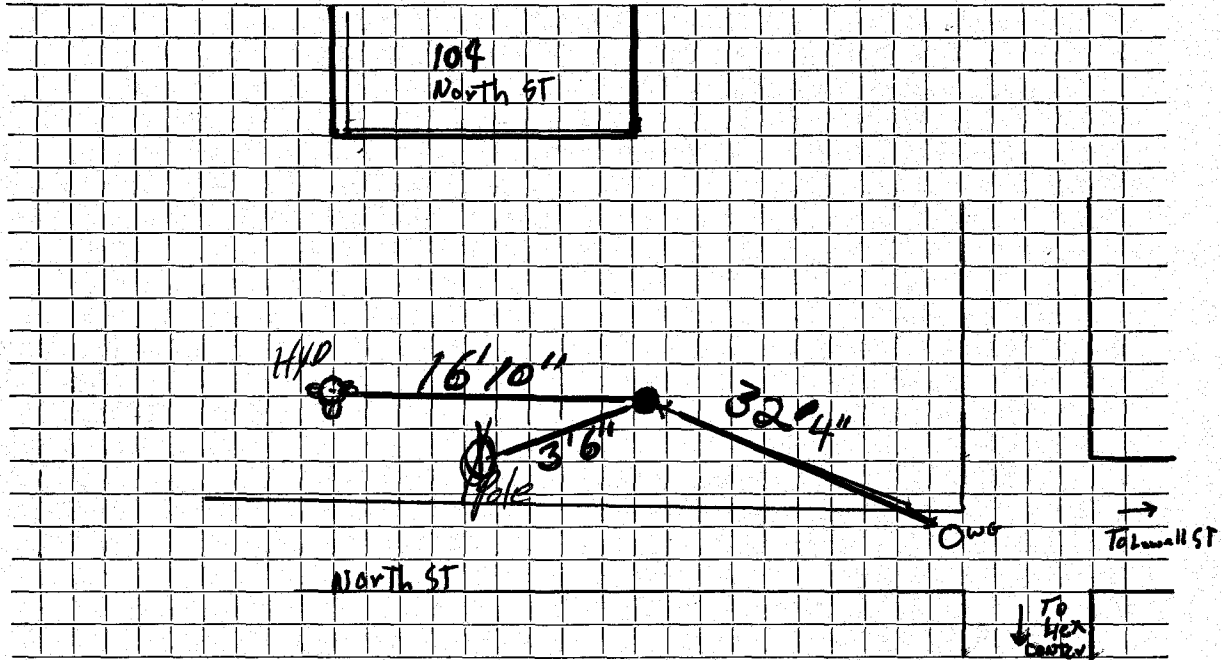

Connection made in ..... Street. Work completed .....

Remarks: .....

.....

.....