

Name John W. MacLeod

Service No. 224

1511

Address 11 North Street

Lexington, Mass.

Location 11 North Street

Kind of Pipe

Size

Size of Main

~~RENEWAL~~—New Service

Com. 12-5-49

Location

Date	Material	Amount	Total	Date	Amount
Oct. 25, '49	Labor	3 00	3 00	Oct 10 '49	60 00
	10% Overhead		30	Dec 23 '49	6 99
	72' - 3/4" Copper Tubing @.24	17 28			No Charge
	1 - 3/4"C x 1/2" I.W.H. S&W	3 29		Oct. 25, '49	Labor
	1 - 3/4"C x 3/4" C Union (3pts)	1 39			30' - 3/4" Copper Tubing @.24
	Littlefield Shovel 1 hr. @7.00	7 00			1 - 3/4" C Corp-cock
	Trucking 1 hr. @.75		75		1 - 3/4"C x 3/4"C Curb-cock
	Patching 20 x 3		20 00		1 - Box & Rod
			53 01		1 - 1/2" Offset Tail Piece
					1 - 1/2" Straight Tail Piece
					Littlefield Shovel 3 hrs. @7.00
					Trucking 1 hr. @.75
	Labor				144 74

TOWN OF LEXINGTON - BOARD OF PUBLIC WORKS

**WATER DIVISION**

The undersigned applies for a supply of water at No..... St. and hereby agrees to comply with the rules and regulations as now, or at any future time, established by the Board of Selectmen.

Am't of Estimate \$.....

Owner .....


Am't Paid \$.....

Address .....

Builder .....

.....

Sketch of Service Here

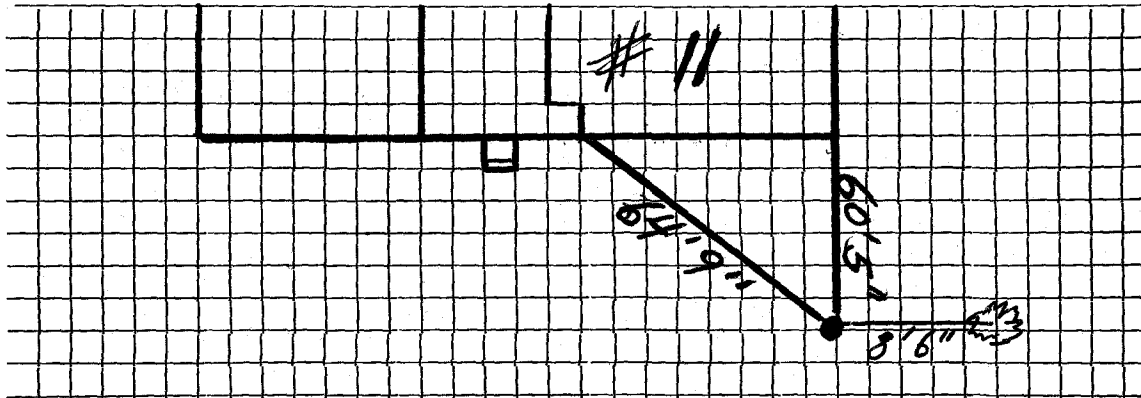

Connection made in ..... Street.

Work completed .....19

Remarks: