

Name Winston Johnson

Service No. 43

Address 12 North Street

Lexington, Mass.

Location 12 North Street

Kind of Pipe

Size

Size of Main

~~Repair - Downway~~ New Service

Com. 5/22/50

Location

Date	Material	Amount	Total	Date	Amount
Apr. 11, '50	Labor	2 45	2 45	Apr. 8 '50	40 00
	10% Overhead		25	Deposited	
	48' - 3/4" Copper Tubing @.23	11 04		Refunded	8 83
	1 - 3/4" C x 1/2" I.W.H. S&W	3 29		No Charge	31 17
	1 - 3/4" C x 3/4" C Union (3pts)	1 39		Apr. 11, '50	2 45
	Littlefield Shovel 1 hr. @ 7.00	7 00		9' - 3/4" Copper Tubing @.23	2 07
	Trucking 1 hr. @.75	75		1 - 3/4" C Corp-cock	3 15
	Patching 5 x 3	5 00		1 - 3/4" C x 3/4" C Curb-cock	3 85
			31 17	1 - Box & Rod	3 70
				1 - 1/2" Offset Tail Piece	38
				1 - 1/2" Straight Tail Piece	38
				Littlefield Shovel 1 hr. @ 7.00	7 00
				Trucking 1 hr. @.75	75
	Labor				23 73

DATE _____

TOWN OF LEXINGTON - BOARD OF PUBLIC WORKS

WATER DIVISION

The undersigned applies for a supply of water at No..... St. and hereby agrees to comply with the rules and regulations as now, or at any future time, established by the Board of Selectmen.

Am't of Estimate \$.....

Owner


Am't Paid \$.....

Address

Builder

.....

Sketch of Service Here

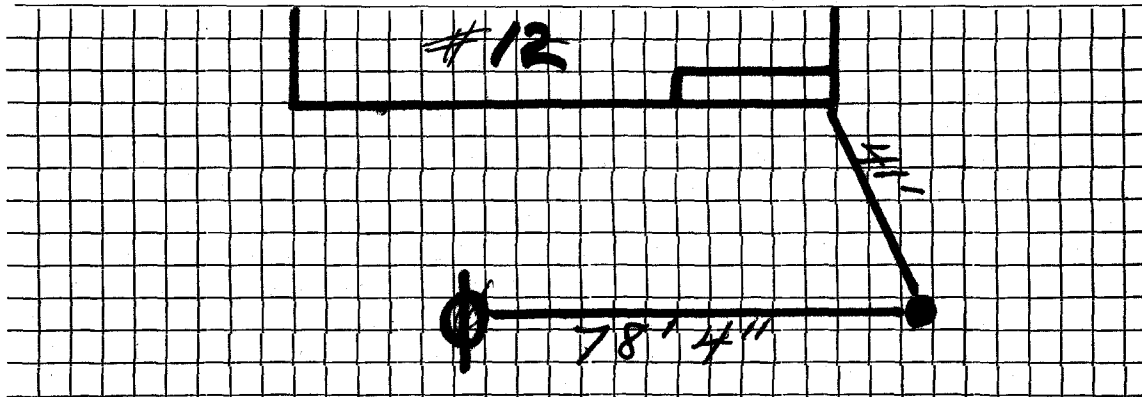

Connection made in Street.

Work completed19

Remarks: