


TOWN OF LEXINGTON - BOARD OF PUBLIC WORKS
WATER DIVISION

Date: _____

SKETCH OF SERVICE HERE

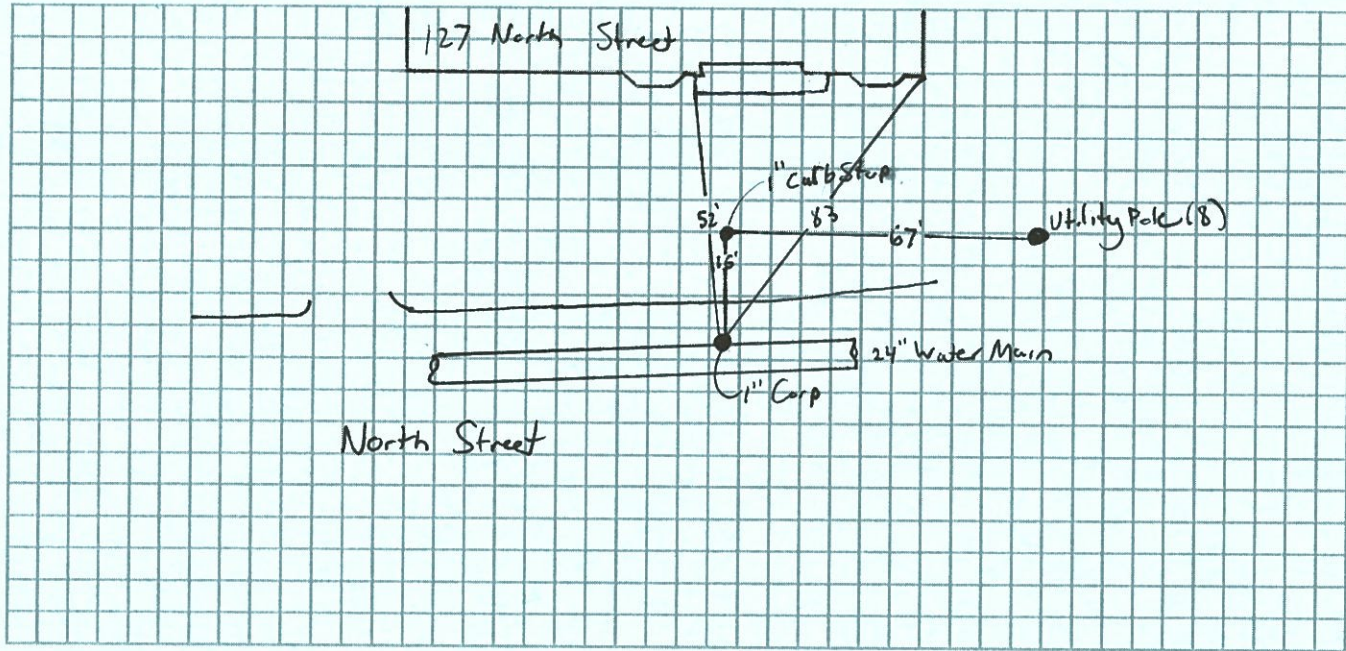

Connection made in: North Street

Street.

Work completed:

Remarks:

.....

.....

