

Name Dr. E. V. Kennelly

Service No. 92

52

Address 13 North Street

Location 13 North Street

Kind of Pipe

Size

Size of Main

~~REPAIR WORK~~ New Service

Com. 8-15-49

Location

| Date | Material | Amount | Total | Date | Amount | |
|-------------|-------------------------------|--------|-------|---------------------------------|------------|-------|
| June 9, '49 | Labor | 3 55 | 3 55 | June 2, '49 Deposited | 45 00 | |
| | 10% Overhead | | 36 | July 1, '49 Refunded | 7 65 | |
| | 60' - 3/4" Copper Tubing @.24 | 14 40 | | | Non-Charge | 35 35 |
| | 1 - 3/4" C x 1/2" I.W.H. S&W | | 3 29 | June 11, '49 Labor | 4 90 | |
| | Trucking 1 hr. @.75 | | 75 | 25' - 3/4" Copper Tubing @.24 | 6 00 | |
| | Patching 13 x 3 | | 13 00 | 1 - 3/4" C Corp-cock | 3 15 | |
| | | | 35 35 | 1 - 3/4" C x 3/4" C Curb-cock | 3 85 | |
| | | | | 1 - Box & Rod | 3 95 | |
| | | | | 1 - 1/2" Offset Tail Piece | 37 | |
| | | | | 1 - 1/2" Straight Tail Piece | 37 | |
| | | | | Littlefield Shovel 3 hrs. @7.00 | 21 00 | |
| | | | | Trucking 1 hr. @.75 | 75 | |
| | Labor | | | | 44 34 | |

TOWN OF LEXINGTON – BOARD OF PUBLIC WORKS

WATER DIVISION

The undersigned applies for a supply of water at No..... St. and hereby agrees to comply with the rules and regulations as now, or at any future time, established by the Board of Selectmen.

Am't of Estimate \$.....

Owner


Am't Paid \$.....

Address

Builder

.....

Sketch of Service Here

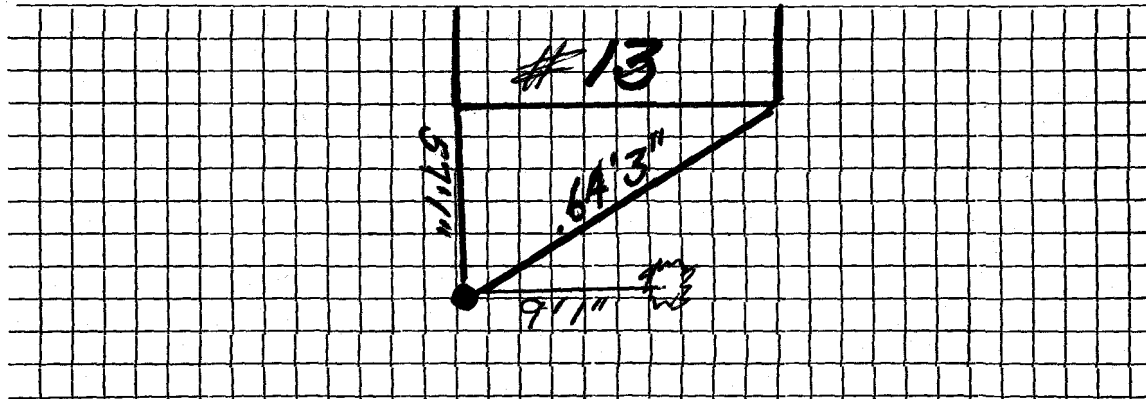

Connection made in Street.

Work completed19

Remarks: