
Date				
Date	-			
	-	-	 _	_

TOWN OF LEXINGTON - BOARD OF PUBLIC WORKS WATER DIVISON

SKETCH OF SERVICE HERE

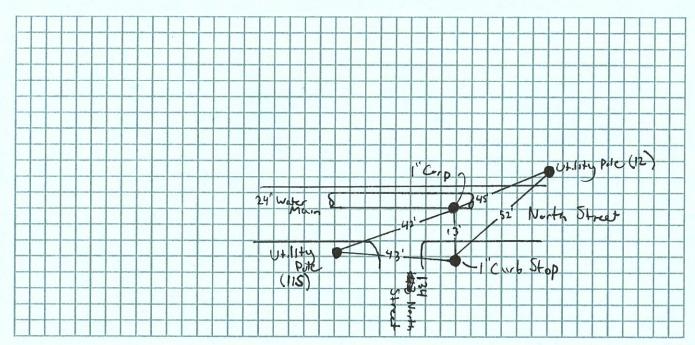

Connection made in:	North	Street	Street.	Work completed:
Remarks:				

Name

Service No.

Address 134 North Street

Location

Repair - Renewal - New Service

Date	Material	Amount	Total	Date	Amount
8/23/22	Material I" Copper I" Curb Stop I" Corporation Scholer	13'	24.75		
	1" Curb Step	1			
	1" Corporation	1			
	Siddle	- 1			