

## WATER SERVICE RECORD

#6153

Name Frank Massimilla

Service No. 143

Address 153 North Street

Location

~~Renewal~~ New Service W.O. # 7654


Comm 12-10-62

Date	Material	Amount	Total	Date	Amount	
10-24-62	Labor	63.06		10-5-62	Deposit	450.00
	10% O.H.	6.31	69.37	12-10-62	Refund	121.57
106	2" Copper tubing @1.30		137.80			328.41
1	2" Comp. Valve		14.85			
3	2" 3 Part Unions @14.98		44.94		NON CHARGE	
1	2" Brass Elbow		1.95	10-24-62	Labor	21.83
2	2X4 Brass Nipples @1.47		2.34	34'	2" Copper tubing @1.30	44.20
1	2" CX2" I Male Adapter		9.16	1	2" C Corp Cock	21.13
26	X 3 Patch		26.00	16	X 2" Service Saddle	7.04
2	Hrs. Town Shovel @6.50		13.00	1	2" O.R. Seal Curb Stop	8.52
2	Hrs. Trucking @3.00		6.00	1	Road Box	12.10
1	Hr. Loader @3.00		3.00	1	Hr. Town Shovel @6.50	6.50
			328.41	1	Hr. Trucking @3.00	3.00
						127.32

TOWN OF LEXINGTON — BOARD OF PUBLIC WORKS

WATER DIVISION

Sketch of Service Here

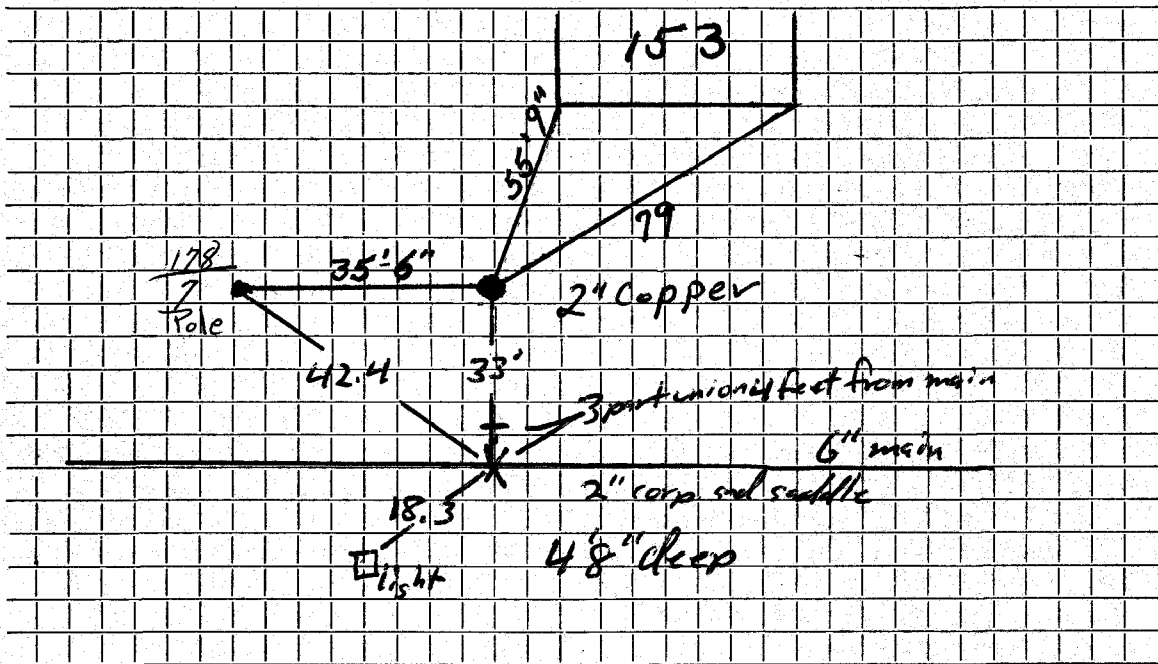

Connection made in ..... Street. Work completed .....

Remarks: NORTH ST.