

Name Arthur WilliamsService No. 119Address 16 North StreetLocation 16 North Street

Kind of Pipe

Size

Size of Main

~~Repair-Overhaul~~—New ServiceCom. 8-15-49

Location

Date	Material	Amount	Total	Date	Amount	
July 9, '49	Labor	1 25	1 25	June 30, '49	10 00	
	10% Overhead		13	<i>Deposited</i>	<u>1 51</u>	
	7' - 3/4" Copper Tubing @.24		1 68	<i>Non-Charge</i>	8 49	
	1 - 3/4" C x 1/2" I.W.H. S&W		3 29	July 9, '49	Labor	9 40
	1 - 3/4" C x 3/4" C Union		1 39	8' - 3/4" Copper Tubing @.24		1 92
	Trucking 1 hr.		75	1 - 3/4" C Corp-cock		3 15
			8 49	1 - 3/4" C x 3/4" C Curb-cock		3 85
				1 - Box & Rod		3 95
				1 - 1/2" Offset Tail Piece		37
				1 - 1/2" Straight Tail Piece		37
				Littlefield Shovel 2 hrs. @7.00		14 00
				Trucking 1 hr.		<u>75</u>
	Labor					37 76

DATE \_\_\_\_\_

# TOWN OF LEXINGTON - BOARD OF PUBLIC WORKS

## WATER DIVISION

The undersigned applies for a supply of water at No..... St. and hereby agrees to comply with the rules and regulations as now, or at any future time, established by the Board of Selectmen.

Am't of Estimate \$.....

Owner .....


Am't Paid \$.....

Address .....

Builder .....

.....

### Sketch of Service Here

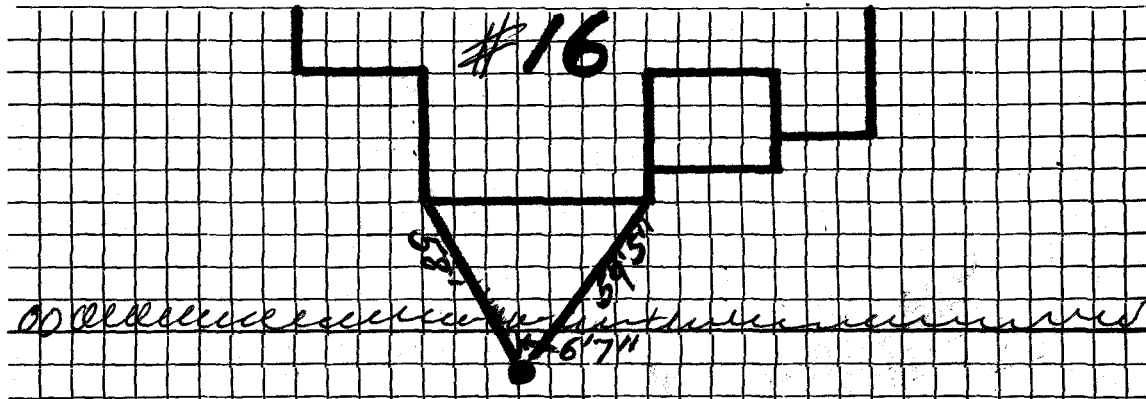

Connection made in ..... Street.

Work completed .....19

Remarks: