

WATER SERVICE RECORD

Name Frank Lancelotta

Service No. 385

Address 160 North Street

# 5878

Location Lexington, Mass.

~~Repair - Renewal~~ - New Service

Com. 12-31-50

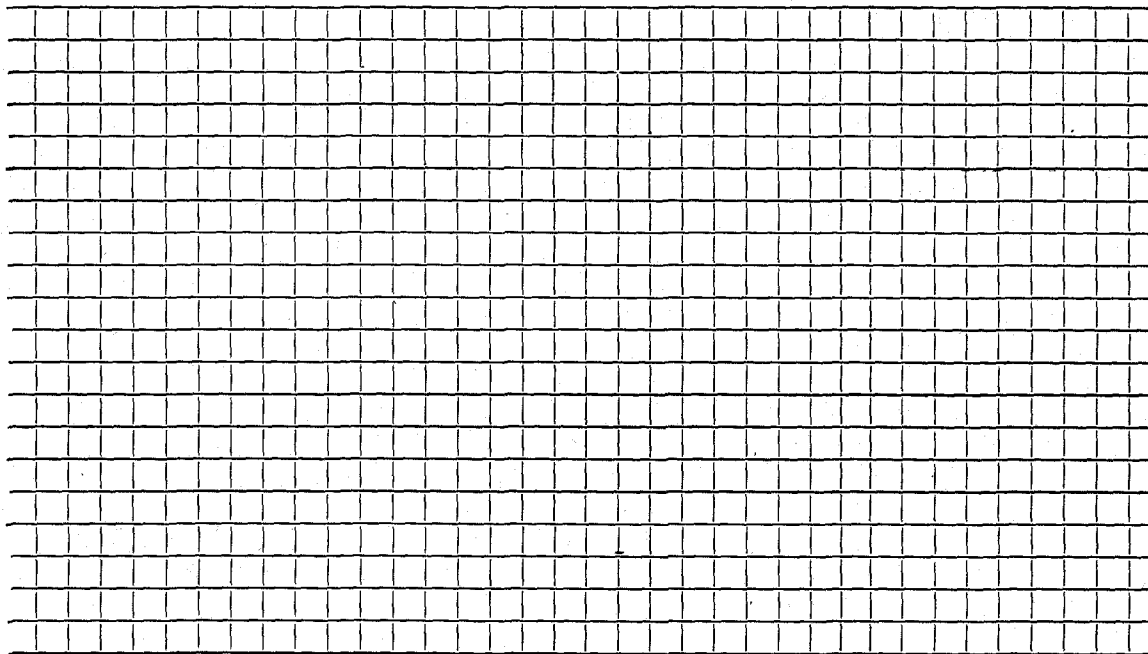
Date	Material	Amount	Total	Date	Material	Amount
Dec. 5, '50	Labor	2 65	2 65	Jan 31, 51	Paid	17 78
	10% Overhead		27			
	31' - 3/4" Copper Tubing @ .334	10 35	10 35		No Charge	
	1 - 3/4" C x 1/2" I.W.H. S&W	3 76	3 76	Dec. 5, '50	Labor	2 65
	Trucking 1 hr. @ .75	75	75	5' - 3/4" Copper Tubing @ .334		1 67
			17 78	1 - 3/4" C Corp-cock		3 60
				1 - 3/4" C x 3/4" C Curb-cock		4 40
				1 @ Box & Rod		3 35
				1 - 1/2" Straight Tail Piece		42
				1 - 1/2" Offset Tail Piece		42
				Brox Shovel 1 hr. @ 9.00		9 00
				Trucking 1 hr. @ .75		75
						26 26

*Bell sent 1-12-51*

DATE \_\_\_\_\_

**TOWN OF LEXINGTON — BOARD OF PUBLIC WORKS**  
**WATER DIVISION**

Sketch of Service Here

A large grid consisting of 22 columns and 20 rows of small squares, intended for sketching service details. The grid is centered on the page below the title.

Connection made in ..... Street.                      Work completed .....

Remarks: .....  
.....  
.....