

WATER SERVICE RECORD

Name Frank Massimilla

Service No. 39

Address 161 North Street

Location

Repair—Renewal—New Service

WO# 8701

JUN 29 1964


Date	Material	Amount	Total	Date	Amount
5/13/64	Labor	9 35		4-28-64	Deposit 150 00
	10% O.H.	94	10 29	6-29-64	Return 85 48
	43' 3/4" COPPER Tubing @ .42		18 06		64 62
	1 3/4" Cx 1/2 I.W.H. Stop & Waste		6 17		
	24 X 3 Patch		24 00		32' 3/4" Copper Tubing @ .42 13 44
	2 Hr. Trocking @ 3.00		6 00		1 3/4" Corp Cock 4 91
			64 52		1 3/4" Curb Cock 6 28
					1 Bow & Rod 4 90
					1 1/2 Straight Tailpiece 50
					1 1/8 Offset Tailpiece 50
					2 Hrs. Town Shovel @ 6.50 13 00
					43 53

DATE _____

TOWN OF LEXINGTON — BOARD OF PUBLIC WORKS

WATER DIVISION

Sketch of Service Here

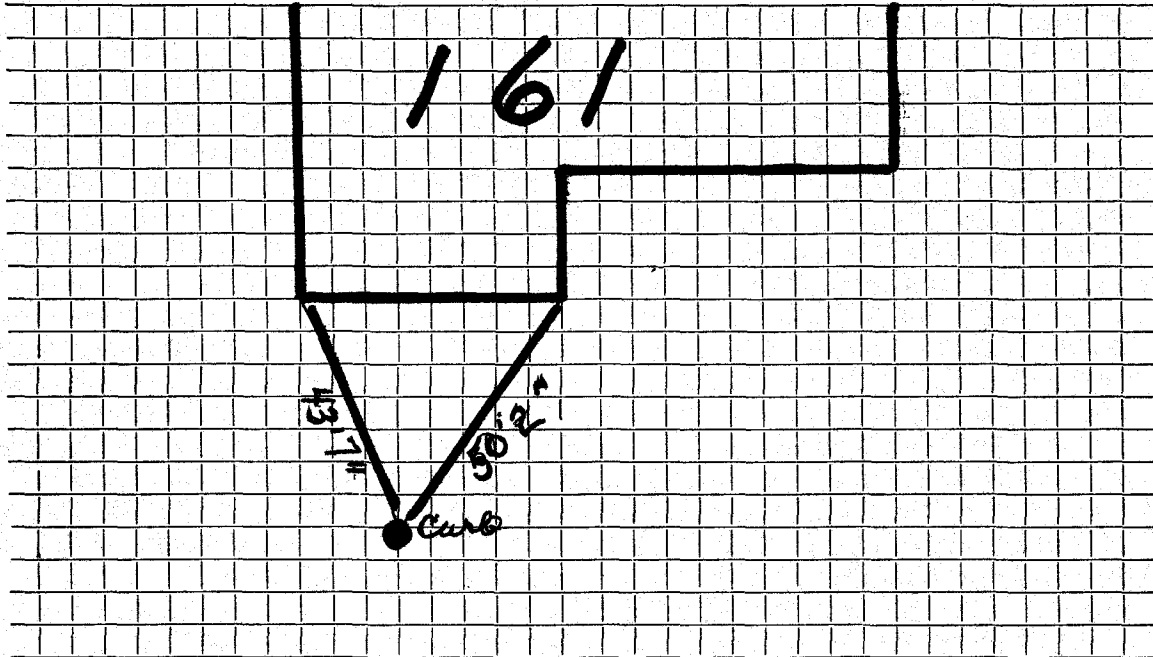

Connection made in Street. Work completed

Remarks:

.....

.....