

WATER SERVICE RECORD

Name Joseph Graziano

Service No. 113

Address 162 North St.,

Location Lexington

~~Repair~~ ~~Renewal~~ ~~New Service~~

*Com 7-28-52*


Date	Material	Amount	Total	Date	Amount
6/30/52	Labor	1 63		6-19-52 Deposited	25 00
	10% Overhead	16	1 79	10-23-52 Paid	2 02
	45' - 3/4" Copper tubing@.3439	15 48		<u>NON CHARGE</u>	
	1 - 3/4" C X 1/2 I.W.H.Stop&Waste	4 00		6/30/52 Labor	4 41
	1 hr. trucking		75	15' - 3/4" Copper tubing@.3439	5 16
	patching 5 X 3		5 00	1 - 3/4" C. Corp-Cock	4 33
			27 02	1 - 3/4" C. Curb-cock	4 67
				1 Box and Rod	4 52
				1 - 1/2" straight tail piece	50
	TRENCH DUG BY OWNER			1 - 1/2" offset tail piece	50
				2 hrs. Littlefield Shovel	14 00
				1 hr. trucking	75
					<u>38 84</u>
				<i>bill sent 7-28-52</i>	

DATE \_\_\_\_\_

TOWN OF LEXINGTON — BOARD OF PUBLIC WORKS

WATER DIVISION

Sketch of Service Here

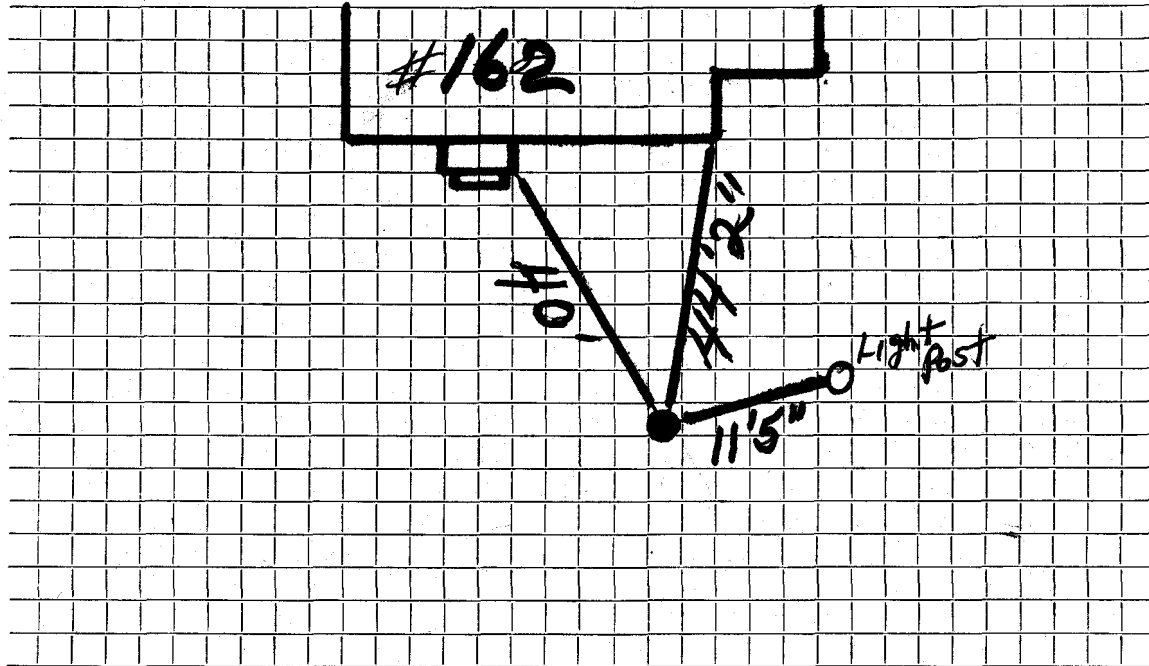

Connection made in ..... Street. Work completed .....

Remarks: .....

.....

.....